

**OREGON CORNER RESTORATION FORM**

Section 23 Township 3N  
County Umatilla Date: 03/14/11

Range 33E

Corner Designation: 3N33R1

1/4 corner common to sections 23 and 26, T3NR33E.

- Condition Report Only
- Not Found
- Remonumented
- Unrecorded
- Surveyed In
- Referenced Out


**Previous Renewals / Surveys, etc.**

Originally Surveyed by Thompson in 1864. He set a post in a mound of earth.


**Monuments and Accessories Found: (Condition and Source)**

None. Fence evidence and road.

**Diagram**

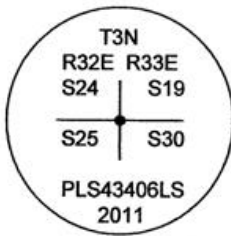

**Sketch**

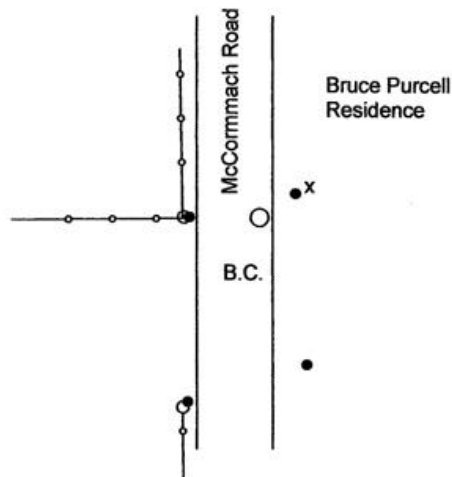

NAD 83/91  
OREGON STATE PLANE NORTH  
INTERNATIONAL FEET

N752727.62  
E8650211.30

**Monument (s) Set (Procedures and Description)**

A 1 1/8" X 30" galvanized iron pipe with a 2 1/2" B.C., 19" below surface, at fence projection and held North-South line between found monuments.

**References Set:**

- A 5/8" x 30" iron rebar w/rpc #43406, lies N 78°10' E, 7.61'.
- A Pink magnet, 16" deep, lies S 20°30' E, 42.66'.
- A 5/8" x 30" iron rebar w/rpc #43406, lies S 18°10' W, 64.25'.
- A 5/8" x 30" iron rebar w/rpc #43406, lies N 74°40' W, 26.29'.

**Location and Comments**

The monument is in McCormach Road near Purcells' House.

**Compass Declination**

17° E

**Surveyors Seal**

REGISTERED  
PROFESSIONAL  
LAND SURVEYOR,

*Robert D. English*  
OREGON  
JANUARY II, 2005  
ROBERT DOUGLAS ENGLISH  
43406LS

**RECEIVED BY:**

Date: \_\_\_\_\_  
Rec'd By: \_\_\_\_\_  
No. \_\_\_\_\_

**Firm / Agency**

Survey One, LLC.  
P.O. Box 382  
Pendleton, OR 97801  
(541) 276-2055

RENEWAL DATE: 12/31/11