

**OREGON CORNER RESTORATION FORM**

Section: 28, 29      Township: 3N      Range: 33E  
 County: Umatilla      Date: 10/11/2011

Corner Designation: 3N33T09

Quarter corner common to Sections 28, 29, T3NR33E.

	Condition Report Only
X	Not Found
X	Remonumented
	Unrecorded
X	Surveyed In
X	Referenced Out


**Previous Renewals / Surveys, etc.**

Originally surveyed by Chaplin in 1864. He set a post in a mound of earth with charred stake and pits.  
 In 1887 Currin and Noland set a post in a mound of earth and dug pits.


**Monuments and Accessories Found: (Condition and Source):**

None.

**Diagram**

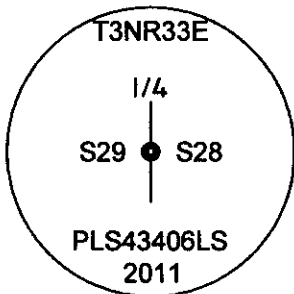

**Sketch**

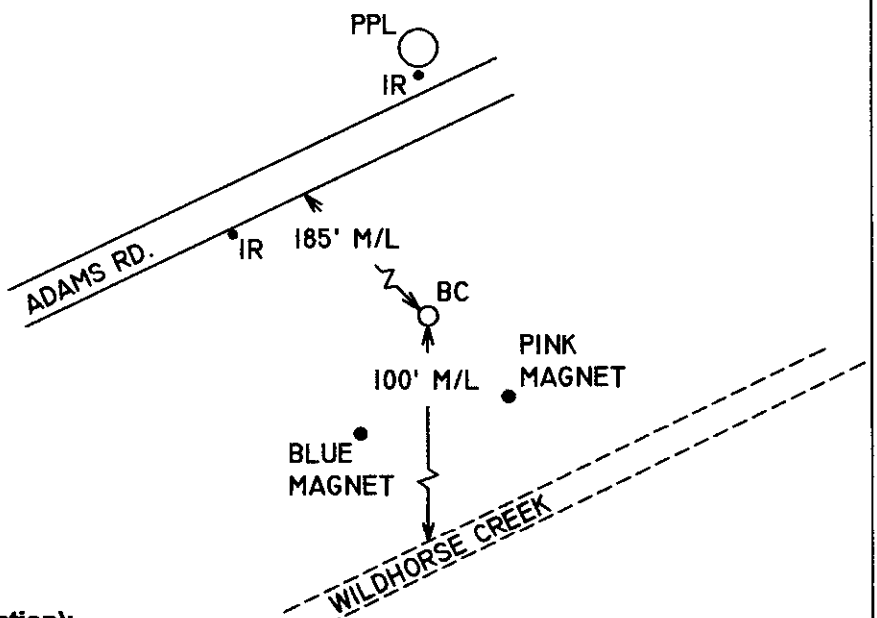

NAD 83/91  
 OREGON STATE PLANE NORTH  
 INTERNATIONAL FEET

N750293.24  
 E8660781.08

**Monument(s) Set (Procedures and Description):**

A 1 1/8" x 30" galvanized iron pipe with 2 1/2" brass cap, stamped as shown above, 1.4' below the surface.  
 The corner location was reestablished by single proportionate method between neighboring found monuments to the North and South.

**References Set:**

- "Deep One" magnets by Berntsen.
- A 5/8" x 30" iron rebar w/RPC #43406 lies N 52° 25' W, 184.89'.
- A 5/8" x 30" iron rebar w/RPC #43406 lies N 0° 45' W, 278.63', at a post.
- A pink magnet lies S 44° E, 23.28', 1.5' deep.
- A blue magnet lies S 30° 50' W, 27.92', 1.6' deep.

**Location and Comments:**

The corner is located 0.4 miles, M/L,  
 Northeast of the intersection of Adams Rd.  
 and Myrick Rd.

**Compass Declination**

17° E

**Surveyors Seal**

REGISTERED  
 PROFESSIONAL  
 LAND SURVEYOR

*Robert Douglas English*  
 OREGON  
 JANUARY 11, 2005  
 ROBERT DOUGLAS ENGLISH  
 43406LS

RENEWAL DATE: 12/31/13

**RECEIVED BY:**

Date: 7/10/2012  
 Rec'd By: S. Oles  
 No. 12-094-C

**Firm / Agency**

Survey One, LLC.  
 P.O. Box 382  
 Pendleton, OR 97801  
 (541) 276-2055