

**OREGON CORNER RESTORATION FORM**

Section: 27, 34  
County: Umatilla

Township: 3N  
Date: 3/20/2012

Range: 33E

Corner Designation: 3N33V15

Quarter corner common to Sections 27, 34, T3NR33E.

	Condition Report Only
X	Not Found
X	Remonumented
	Unrecorded
X	Surveyed In
X	Referenced Out


**Previous Renewals / Surveys, etc.**

Originally surveyed by Chaplin in 1864. He set a post in a mound of earth, with charred stake and pits.  
 In 1871 Moody set a post in a mound of earth.  
 In 1887 Currin and Noland buried charred stake under a mound of earth, dug pits to the East and West, and set a stake in the Eastern pit.  
 In 1998 Krumbein set a brass cap in Survey 11-85-C. This survey was not filed until after several subsequent surveys were filed, including the corners set in our survey. This creates the distinct probability that there are double corners in the survey affected by 11-85-C.


**Monuments and Accessories Found: (Condition and Source):**

None.

Diagram

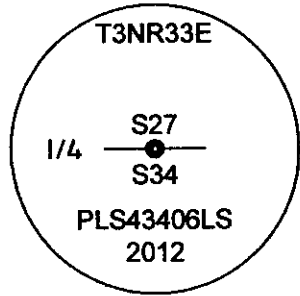

Sketch

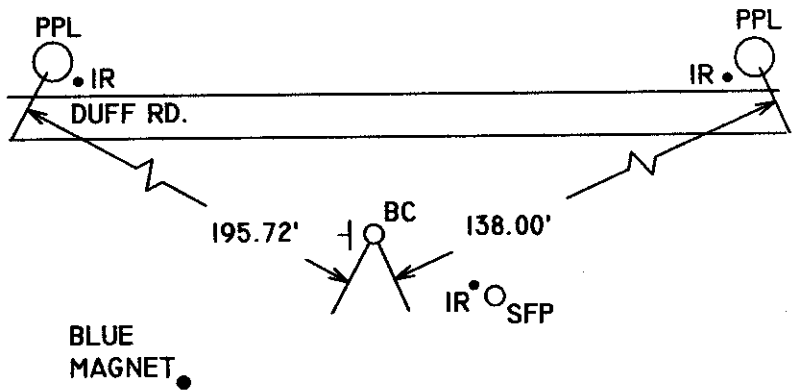

NAD 83/91  
OREGON STATE PLANE NORTH  
INTERNATIONAL FEET

N747817.74  
E8668780.35

**Monument(s) Set (Procedures and Description):**

A 1 1/8" x 30" galvanized iron pipe with 2 1/2" brass cap, stamped as shown above, 0.6' below the surface.  
 The corner location was reestablished by single proportionate method between neighboring corners to the East and West.

**References Set:**

- "Deep One" magnet by Bermtsen.
- A 5/8" x 30" iron rebar w/YPC #43406 lies N 76° 55' W, 195.72', at a power pole.
- A 5/8" x 30" iron rebar w/YPC #43406 lies N 67° 30' E, 138.00', at a power pole.
- A 5/8" x 30" iron rebar w/YPC #43406 lies S 63° 35' E, 11.69', at a steel fence post set in concrete.
- A blue magnet lies S 53° 25' W, 25.21', 2.0' deep.

**Location and Comments:**

The corner is located 1/2 mile East of the intersection of Hwy. 11 and South Market Rd., 12' South of Duff Road's South edge of pavement.

**Compass Declination**

17° E

**Surveyors Seal**

REGISTERED  
PROFESSIONAL  
LAND SURVEYOR

*Robert D. English*  
OREGON  
JANUARY 11, 2005  
ROBERT DOUGLAS ENGLISH  
43406LS

RENEWAL DATE: 12/31/13

**RECEIVED BY:**

Date: 7/10/2012  
 Rec'd By: A. Gles  
 No. 12-094-C

**Firm / Agency**

Survey One, LLC.  
 P.O. Box 382  
 Pendleton, OR 97801  
 (541) 276-2055