

**OREGON CORNER RESTORATION FORM**

Section: 26, 35  
County: Umatilla

Township: 3N  
Date: 12/21/2011

Range: 33E

Corner Designation: 3N33V19

Quarter corner common to Sections 26, 35, T3NR33E.

_____	Condition Report Only
<u>  X  </u>	Not Found
<u>  X  </u>	Remonumented
_____	Unrecorded
<u>  X  </u>	Surveyed In
<u>  X  </u>	Referenced Out


**Previous Renewals / Surveys, etc.**

Originally surveyed by Chaplin in 1864. He set a post in a mound of earth with charred stake and pits.  
In 1871 Moody set a post in a mound of earth.  
In 1887 Currin and Noland buried a charred stake under a mound of earth, dug pits East and West, and set a stake in the East pit.


**Monuments and Accessories Found: (Condition and Source):**

None.

**Diagram**

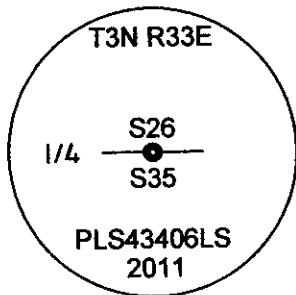

**Sketch**

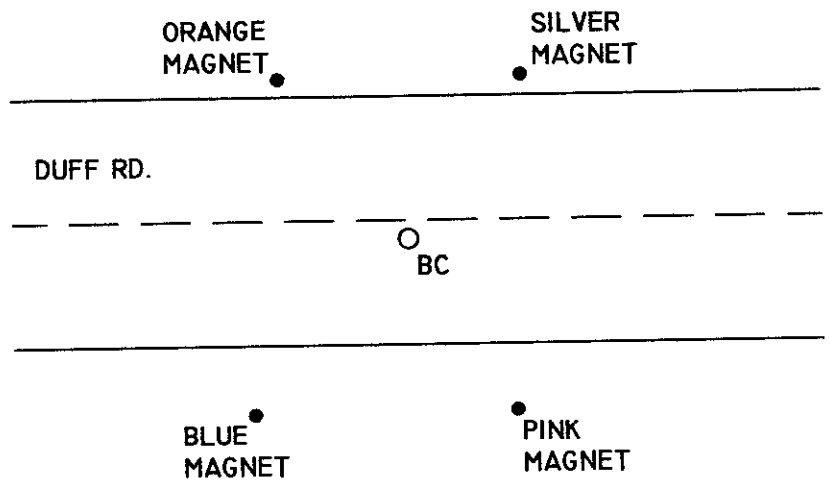

NAD 83/91  
OREGON STATE PLANE NORTH  
INTERNATIONAL FEET

N747947.81  
E8674069.67

**Monument(s) Set (Procedures and Description):**

A 1 1/8" x 30" galvanized iron pipe with 2 1/2" brass cap, stamped as shown above, 4" below the surface. The corner location was reestablished by single proportionate method between neighboring corners to the East and West.

**References Set:**

"Deep One" magnets by Berntsen.  
An orange magnet lies N 38° 20' W, 21.50', 1.8' deep.  
A silver magnet lies N 35° 45' E, 20.68', 1.5' deep.  
A pink magnet lies S 30° 50' E, 20.10', 1.5' deep.  
A blue magnet lies S 42° 30' W, 24.65', 1.5' deep.

**Location and Comments:**

The corner is located 1 1/2 miles East of the intersection of Hwy. 11 and Duff Rd., 1', M/L, South of the centerline stripe on the pavement of Duff Rd.

**Compass Declination**

17° E

**Surveyors Seal**

REGISTERED  
PROFESSIONAL  
LAND SURVEYOR

*Robert D. English*

OREGON  
JANUARY 11, 2005  
ROBERT DOUGLAS ENGLISH  
43406LS

**RECEIVED BY:**

Date: 7/10/2012  
Rec'd By: S. Ows  
No. 12-094-C

**Firm / Agency**

Survey One, LLC.  
P.O. Box 382  
Pendleton, OR 97801  
(541) 276-2055

RENEWAL DATE: 12/31/13