

**OREGON CORNER RESTORATION FORM**

Section: 25, 26, 35, 36 Township: 3N Range: 33E  
 County: Umatilla Date: 12/20/2011

Corner Designation: 3N33V21

Section corner common to Sections 25, 26, 35, 36, T3NR33E.

	Condition Report Only
X	Not Found
X	Remonumented
	Unrecorded
X	Surveyed In
X	Referenced Out


**Previous Renewals / Surveys, etc.**

Originally surveyed by Chaplin in 1864. He set a post in a mound of earth with charred stake and pits.  
 In 1871 Moody set a post in a mound of earth.  
 In 1887 Currin and Noland set a post in a mound of earth and dug pits in each section.  
 In 1910 J. Kimbrell found the corner in Private Survey #322 as recorded in Book 2, pg. 179.


**Monuments and Accessories Found: (Condition and Source):**

None.


**Diagram**

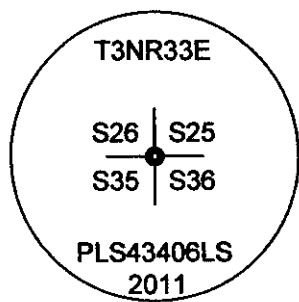

**Sketch**

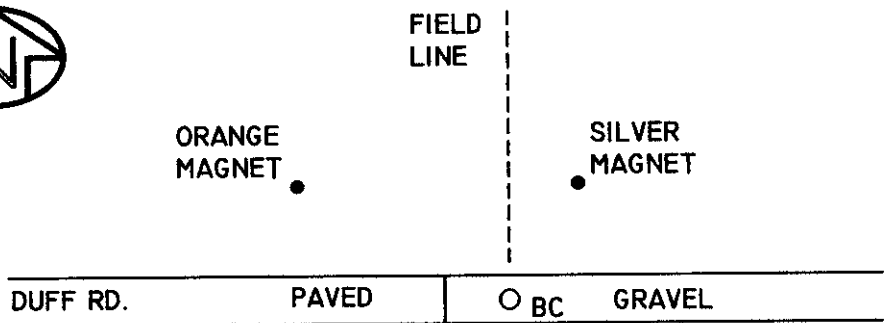

NAD 83/91  
 OREGON STATE PLANE NORTH  
 INTERNATIONAL FEET  
 N747995.51  
 E8676704.45

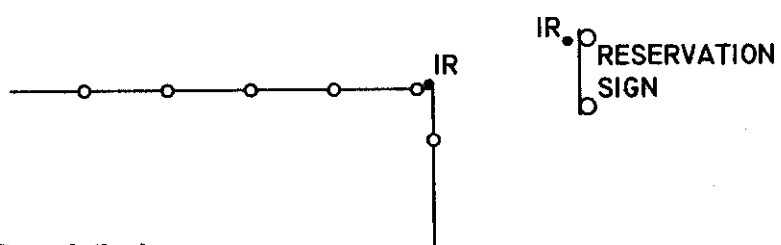

**Monument(s) Set (Procedures and Description):**

A 1 1/8" x 30" galvanized iron pipe with 2 1/2" brass cap, stamped as shown above, 1.35' below the surface. The corner location was reestablished at the intersection of the centerline of Duff Rd. and the projection of the field line to the North. This position checks well with both GLO records and proportioning.

**References Set:**

- "Deep One" magnets by Berntsen.
- An orange magnet lies N 61° 30' W 49.41', 1.7' deep.
- A silver magnet lies N 31° 50' E, 28.10', 1.7' deep.
- A 5/8" x 30" iron rebar lies S 34° 30' E, 23.71', at a sign.
- A 5/8" x 30" iron rebar lies S 28° 20' W, 232.90', at a fence corner post.

**Location and Comments:**

The corner is located in the centerline of Duff Rd., 2 miles East of the intersection of Hwy. 11 and Duff Rd.

**Compass Declination**

17° E

**Surveyors Seal**

REGISTERED  
 PROFESSIONAL  
 LAND SURVEYOR

*Robert D. English*

OREGON  
 JANUARY 11, 2005  
 ROBERT DOUGLAS ENGLISH  
 43406LS

RENEWAL DATE: 12/31/13

**RECEIVED BY:**

Date: 7/10/2012  
 Rec'd By: S. Gles  
 No. 12-094-C

**Firm / Agency**

Survey One, LLC.  
 P.O. Box 382  
 Pendleton, OR 97801  
 (541) 276-2055