

OREGON CORNER RESTORATION FORM

Section 31 Township 3N Range 33E
 County Umatilla Date: May 5, 2001

Corner Designation: 3N33V5

Corner to sections 29, 30, 31, and 32, T3N, R33E,
 W.M., Umatilla County, Oregon.


Condition Report Only
 Not found
 Remonumented
 Unrecorded
 Surveyed in
 Referenced out

Previous Renewals / Surveys, etc.


Corner originally set by Daniel Chaplin under contract #107 dated September 21, 1864.
 His record reads: Set post for corner to secs. 29, 30, 31, & 32 in mound of earth with charred stak
 pits & c. as per instructions. The corner was re-established by John Kimbrell under survey in Book
 1 page 542 of the record of private surveys, March 15, 1904. His record reads: Set stone 18 x 12 x
 8" in a mound of stone.

Monument and Accessories found: (condition and source)
 The stone set by Kimbrell in a mound of stone well settled in the ground.

DIAGRAM

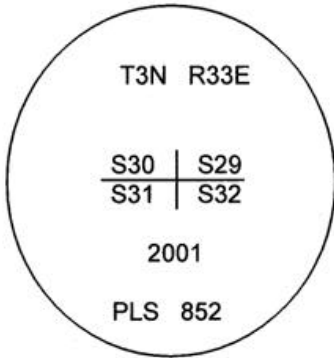

SKETCH

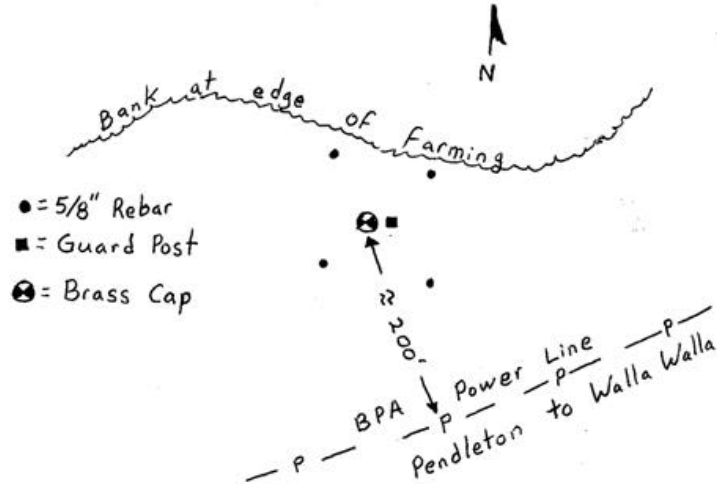

MONUMENT (S) AND ACCESSORIES SET (Procedures and Description)

Set a 1 1/2" x 30" galvanized iron pipe with a 2 1/4" brass cap stamped as shown in the diagram above at the position of Kimbrell's stone. Raised a mound of stone, 3' base x 1 1/2' high around the monument. Set a 6 foot steel fence post with a County monument sign attached along side.

For references, I set four, 5/8" by 24" rebars with 1.25" red plastic caps stamped ORLS 852 and WAL5 13922 as described below:

- an iron rebar bears N43°24'26"W, 29.09 feet;
- an iron rebar bears N60°56'05"E, 21.64 feet;
- an iron rebar bears S60°31'57"W, 32.34 feet;
- an iron rebar bears S44°12'12"E, 32.32 feet;

The monument and references were tied using a LIECA system 300 RTK GPS.

Location and comments

Compass Declination

Surveyors Seal

RECEIVED BY:
 Umatilla County Surveyor
 Date: 6-01
 Rec'd By: RF
 No. 01-81-C

Firm / Agency
 Haddock Surveying
 Address
 P.O. Box 1574
 Pendleton, Or. 97801
 Party Chief
 Stephen K, Haddock

