

OREGON CORNER RELOCATION FORM

Section 4 Township 3N Range 36E
 County Umatilla Date: May 19, 2006

Corner Designation: 3N36E11

Quarter corner to sections 4 and 9, T3N, R36E,
 W.M., Umatilla County, Oregon.

Condition Report Only
 Not found
 Remonumented
 Unrecorded
 Surveyed in
 Referenced out


Previous Renewals / Surveys, etc.

Corner originally set by George S. Pershin under contract No. 305 dated September 20, 1878. His Record reads: Set tamarack post, for 1/4 sec. cor., Pine, 28 in diam. brs. E. 72 lks. dist., Tamarack 13 in diam. brs. N. 46 W. 27 lks.,


Monument and Accessories found: (condition and source)

I found the original tamarack bearing tree stump. The stump was rotten but there were axe marks around the remains of the face and some reverse scribing on bits of the decayed wood in the stump. At the correct bearing and distance I found the rotted remains of the original corner post. The corner point falls approximately 10 feet west and 3 feet south of a fence corner with fences running East, West and South.

DIAGRAM

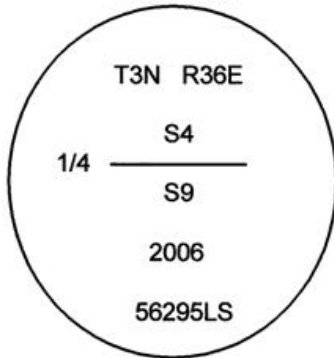

SKETCH

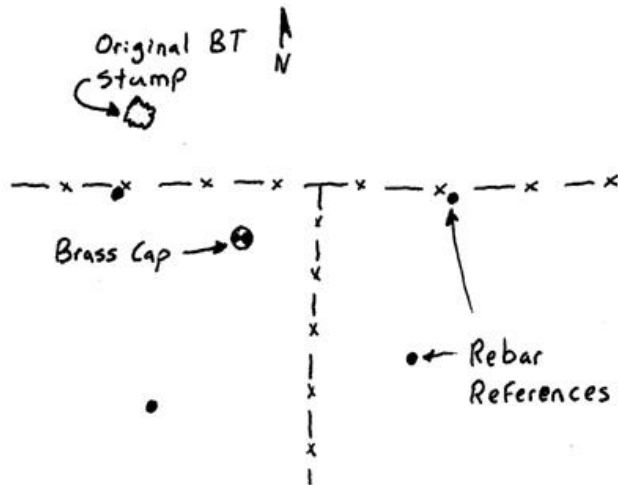

MONUMENT (S) AND ACCESSORIES SET (Procedures and Description)

At the position of the original corner post I set a 1 1/4" x 30" galvanized iron pipe with a 2 3/8" brass cap, stamped as shown in the diagram above, 28 inches in the ground.

For references, I set four 5/8" by 24" rebars with 1 1/8" orange plastic caps stamped WTS and 56295LS as described below:

- an iron rebar bears N81°43'27"E, 22.45 feet under the existing fence;
- an iron rebar bears S51°27'03"E, 39.90 feet;
- an iron rebar bears S38°37'45"W, 45.16 feet;
- an iron rebar bears N80°54'04"W, 23.32 feet under the existing fence;

Bearings given are true. The references were tied using a Trimble 5601 Robotic Total Station.

Location and comments

Compass Declination

Surveyors Seal

RECEIVED BY:
Umatilla County Surveyor
 Date: 7-06
 Rec'd By: KK
 No. 06-472-B

Firm / Agency
 Witness Tree Surveying
 Address
 P.O. Box G
 Pilot Rock, Or. 97868
 Party Chief
 Stephen K. Haddock

REGISTERED
 PROFESSIONAL
 LAND SURVEYOR

Stephen K. Haddock

OREGON
 JULY 9, 2001
 STEPHEN K. HADDOCK
 56295LS

RENEWAL DATE 6-30-07