

OREGON CORNER RELOCATION FORM

Section 3 Township 3N Range 36E
 County Umatilla Date: May 19, 2006

Corner Designation: 3N36E15

Quarter corner to sections 3 and 10, T3N, R36E,
 W.M., Umatilla County, Oregon.


Condition Report Only
 Not found
 Remonumented
 Unrecorded
 Surveyed in
 Referenced out

Previous Renewals / Surveys, etc.

Corner originally set by George S. Pershin under contract No. 305 dated September 20, 1878. His Record reads: Set stone 20 x 10 x 8, on East hillside for 1/4 sec. cor. from which, A pine, 38 in diam. brs. N. 2 E. 126 lks. dist., A pine, 20 in diam. brs. S. 4 E. 77 lks. dist., Mr. Wayne Harris set a 1/2" I.P. in 1956 under survey Q-543-A. His record also calls for a 10" white fir to lie N13 40'W, 16.2'.


Monument and Accessories found: (condition and source)

I found the original stone in place, plainly marked 1/4, approximately 10' west of a north - south fence. The rotted and burned remains of the original SE bearing tree were lying on the ground to the East of the original stump hole which was under the existing fence. I did not find the 1/2" I.P. or the bearing tree set by Harris.

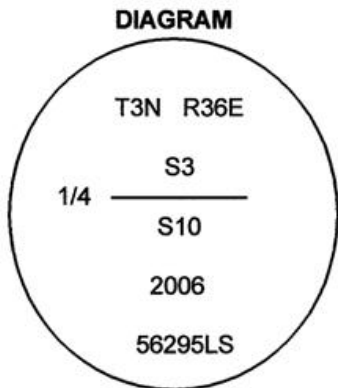

⊙ = Brass Cap
 • = Rebar Reference

SKETCH

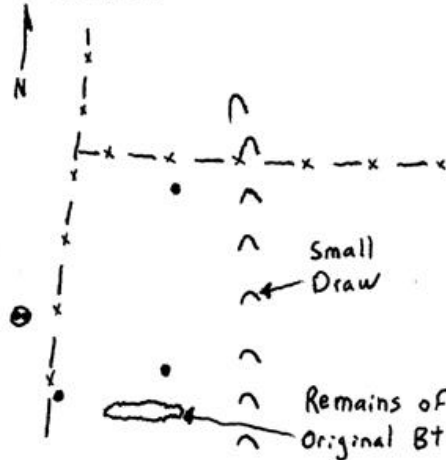

MONUMENT (S) AND ACCESSORIES SET (Procedures and Description)

At the position of the original stone I set a 1 1/4" x 30" galvanized iron pipe with a 2 3/8" brass cap stamped as shown in the diagram above, 26 inches in the ground. I buried the original stone on the east side of the pipe.

For references, I set four 5/8" by 24" rebars with 1 1/8" orange plastic caps stamped WTS and 56295LS as described below:

- an iron rebar bears N24°22'13"E, 81.30 feet;
- an iron rebar bears S44°19'36"E, 71.30 feet;
- an iron rebar bears S12°31'45"E, 50.71 feet in the original BT stump hole;
- an iron rebar bears S74°21'11"W, 32.90 feet;

Bearings given are true. The references were tied using a Trimble 5601 Robotic Total Station.

Location and comments

Compass Declination

Surveyors Seal

RECEIVED BY:
Umatilla County Surveyor
 Date: 7-06
 Rec'd By: KK
 No. 06-472-B

Firm / Agency
 Witness Tree Surveying
 Address
 P.O. Box G
 Pilot Rock, Or. 97868
 Party Chief
 Stephen K, Haddock

REGISTERED
 PROFESSIONAL
 LAND SURVEYOR

Stephen K. Haddock
 OREGON
 JULY 9, 2001
 STEPHEN K. HADDOCK
 56295LS

RENEWAL DATE 6-30-07