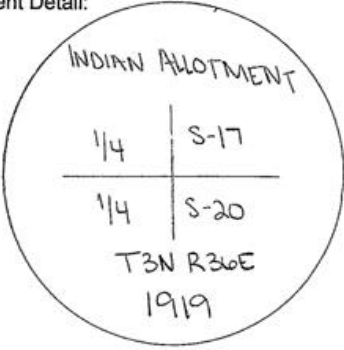
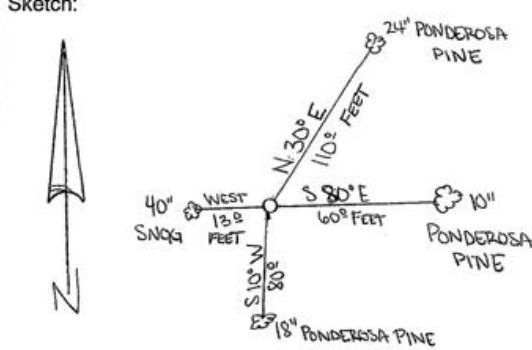
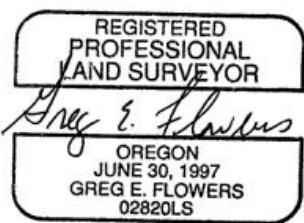


OR **ON PUBLIC LAND CORNER REPORT / RESTORATION REPC**
Umatilla County Surveyor's Office

SECTION 17 and 20	TOWNSHIP 3N	RANGE 36E
COUNTY: Umatilla		DATE 6/20/08
CORNER DESIGNATION: N-7 ¼ Corner common to Sections 10 and 20		(Please check one) <input type="checkbox"/> Condition Report Only <input type="checkbox"/> Not Found <input type="checkbox"/> Renewed <input type="checkbox"/> Unrecorded <input checked="" type="checkbox"/> Surveyed In <input type="checkbox"/> Referenced Out
Previous Renewals / Surveys, etc. This corner was originally set by U.S. Deputy J.P. Currin and J.E. Noland under their contract dated May 4, 1887. The Deputy Surveyors notes state, "Set basalt stone 14x12x10 ins 8 ins in the ground for ¼ section corner marked ¼ on N. face and raised a mound of stone 1 ½ feet high 4 ½ foot base over it." U.S. Indian Services Surveyor C.E. Redfield did not find any evidence of the original corner and set an iron post at the surveyed location in 1919.		
Monument(s) & Accessories Found: (Condition & Source) At the surveyed position, found a 2"x36" galvanized iron pipe with a 2 ½" brass cap laying on the ground.		
Monument Detail: 	Sketch: 	
Monument Set (Procedures and Description): At the surveyed location along a line between the found corner common to Sections 16, 17, 20 and 21 and the found West 1/16 corner common to Sections 17 and 20 found the Redfield monument laying on the ground and reset it 15 inches in the ground.		
New Accessories: A 40" Ponderosa Pine snag 8' tall bears West 13 feet A 18" Ponderosa Pine bears S 10°W 80 feet marked ¼ S BT A 10" Ponderosa Pine bears S 80°E 60 feet marked ¼ S BT A 24" Ponderosa Pine bears S 30°E 110 feet marked ¼ S BT All BT's have bearing tree signs attached		
Location & Comments: The corner is located on an East slope in pine timber		Compass Declination: 19° East
Firm / Agency USKH Inc. Address: 5 N. Colville St. Walla Walla, WA 99362 Party Chief Damon Locke		SURVEYOR'S SEAL
Notes		
Witness		

RENEWS 12-13-109

6/30/08

08-112-c