

USDA-FOREST SERVICE

Index

File No. _____

CORNER RECORD (SEARCH)

(Rpt. FSM 7151.4)

Tract or

Survey No.

U.I.R.

Cor.

No.

37M

T 3N R. 36E

R.D. WALLA WALLA


County UMATILLA

Merid. WILLAMETTE

N.F. UMATILLA

State OREGON

CORNER DIAGRAM

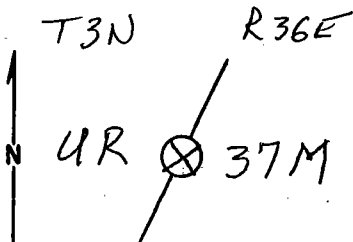

DESCRIBE CORNER MONUMENT FOUND

NONE - THE 1917 BRASS CAP MUST HAVE BEEN DESTROYED OR REMOVED DURING FENCE & GATE CONSTRUCTION ACTIVITIES,

DESCRIBE BEARING TREES OR OTHER OFFICIAL ACCESSORIES FOUND

ORIG. 12" FIR IS NOW A LIVE 24" DOUGLAS FIR WITH A HEALED BLAZE. BEARS N70°E, 53 LINKS,

ORIG. 15" PINE IS A LIVE 30" PONDEROSA PINE. THE FACE HAS RECENTLY BEEN RE-BLAZED & A FENCE POST NAILED TO BLAZE. BEARS N56°W, 13 LINKS,

DESCRIBE CORNER LOCATION RELATIVE TO NEAR-BY FEATURES, ALSO HOW TO REACH CORNER

CORNER IS ON NORTHERLY EDGE OF RIDGE TOP.

PHOTO IDENTIFICATION DATA

Photo No. _____

Filed At. _____

Object Ident. _____

Ident. By _____

Signature

PLANE COORDINATE POSITION DATA

State _____ Zone _____

X _____

Y _____

Estab. By _____

Agency

Signature

Title

Division

Headquarters

Date

FS-7100-52 (3/88)

Wennis K. Taylor PLS 1636

S.O. APRIL 12, 1991

CORNER RECORD (PERPETUATION)

MONUMENT : DESCRIBE NEW MONUMENT SET, OR WORK DONE TO PRESERVE EXISTING MONUMENT

ACCESSORIES : DESCRIBE NEW BT's WITNESS OBJECTS ETC. ESTABLISHED, OR WORK DONE TO PRESERVE EXISTING EVIDENCE

Work Done By _____ Title _____ Date _____ State Registration No. _____
or Agency _____

Certified Cor. Record Prepared ? Yes No Filed At: _____ Date _____

REMARKS

Index File No. T. R. M. Tract or Surv. No.

Cor.