

USDA-FOREST SERVICE

R-11+

Index W.I.R. Boundary

File No. S21-S28

CORNER RECORD (SEARCH)

(Ref. FSM 7151.4)

Tract or Survey No. _____

Cor. No. _____


T 3N R. 36E

R.D. Pendleton County _____

Merid. Williamette

N.F. Umatilla State Oregon

CORNER DIAGRAM

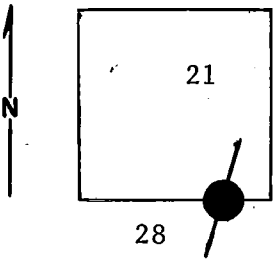


DESCRIBE CORNER MONUMENT FOUND

Material: Brass Cap Size: 2" Diameter
Height Above Ground: ~~10"~~
Condition: Good

3' west of NE-SW Fence

DESCRIBE BEARING TREES OR OTHER OFFICIAL ACCESSORIES FOUND

US General Land Office Survey

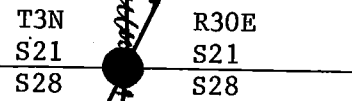

15' North Fence Corner.
Fence East NE-SW.

PHOTO IDENTIFICATION DATA

Photo No. _____
Filed At. _____
Object Ident. _____
Ident. By _____
Signature

DESCRIBE CORNER LOCATION RELATIVE TO NEAR-BY FEATURES, ALSO HOW TO REACH CORNER

N49°W is 24" P. pine w/closed SE blaze apparent BT.

PLANE COORDINATE POSITION DATA

State _____ Zone _____
X _____
Y _____
Estab. By _____
Agency

Signature B. Moore

Title _____

Division _____

Headquarters _____

Date 11/2/79

7100-52-(3/68)

CORNER RECORD (PERPETUATION)

MONUMENT: DESCRIBE NEW MONUMENT SET, OR WORK DONE TO PRESERVE EXISTING MONUMENT

ACCESSORIES : DESCRIBE NEW BT'S WITNESS OBJECTS ETC. ESTABLISHED, OR WORK DONE TO PRESERVE EXISTING EVIDENCE

I placed attention ^{and} BT posters on the 24" P. pine.

Work Done By _____ Title _____ Date _____ State Registration No. or Agency _____

Certified Cor. Record Prepared ? Yes No Filed At: _____ Date _____

REMARKS

Index File No. T. R. M. Tract or Surv. No. Cor. U.S. G.P.O. 1977-725-576/586