

Form 874-9

U. S. DEPARTMENT OF AGRICULTURE
FOREST SERVICE

Unatella NATIONAL FOREST

CORNERS OF THE PUBLIC SURVEY

T. 39 R. 36 E W Mer.

1/4 Corner common to Sections
22, and 27

DESCRIPTION OF CORNER

Corner consists of a ?

Dimension above ground ? inches.

Sketch grooves, letters, figures, or notches, on proper face or edge.

CARDINAL POSITION

DIAGONAL POSITION

--	--	--	--

--	--	--	--

N W S E

NW SW SE NE

Mound of _____ is located _____

Pits are located _____

Sketch markings of Bearing Trees (or Rocks) in proper box and fill blanks below, giving bearings from Corner to Trees and Distances in Links.

	<u>1/4</u> <u>S</u>		

Species D.F.

Diameter 14"

Bearing _____

Distance _____

Do you believe this to be a genuine Land Office Corner? Yes

If not, why? _____

John G. Houston

Signature


5/13/29
Date

Ranger
Title

T. _____ R. _____ Mer.

8-3027

(Make sketch of topography near Corner.)

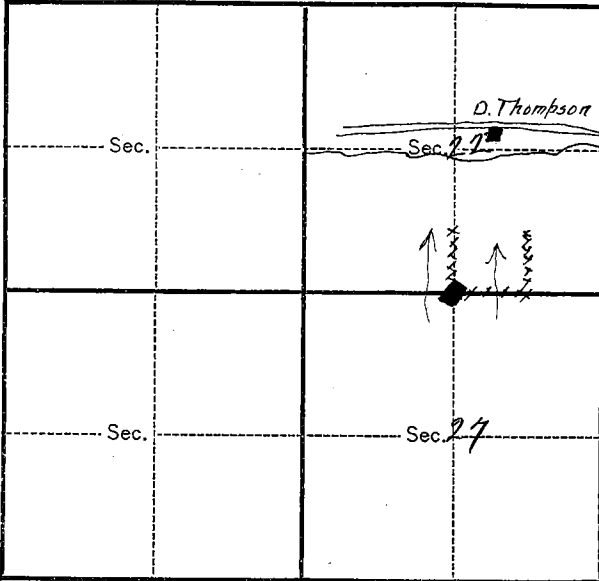

Metal Location Poster is on a _____
tree _____ inches diameter, on the _____
side of _____
from which this Corner bears _____
_____ chains distant.

Give any further facts which will aid in finding this
Corner again.

Corner is at SW corner of
Dolph Thompson's pasture fence
on ridge between two draws and
on north slope into Unatilla
River. Heavy mixed timber