

Index

File No. V-21

CORNER RECORD (SEARCH)

(Ref. FSM 7151.4)

Tract or

Survey No. _____

Cor.

No. _____

T 3N R. 36E

R.D. Walla Walla


County Umatilla

Merid. Willamette

N.F. Umatilla

State Oregon

CORNER DIAGRAM Sec.36

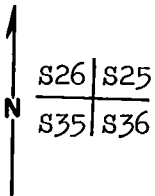

DESCRIBE CORNER MONUMENT FOUND

Orig. 5" now 23" D-Fir corner tree obvious blaze on South-not East as per record.

DESCRIBE BEARING TREES OR OTHER OFFICIAL ACCESSORIES FOUND

Orig. 8" now recent broken & shattered 26" D-Fir-scribing visible on exposed blaze. N50E-80 lks..
 Orig. 12" now 24" D-Fir S18E-140 lks. healed blaze.
 Orig. 10" now 24" D-Fir S61W-100 lks. healed blaze.

DESCRIBE CORNER LOCATION RELATIVE TO NEAR-BY FEATURES, ALSO HOW TO REACH CORNER

Corner is 1/4 mile North from where Boise Cascade Co. road hits ridge top.

PHOTO IDENTIFICATION DATA

Photo No. 1280-54

Filed At Umatilla N.F.

Object Ident. Corner Tree

Ident. By [Signature]
Signature

PLANE COORDINATE POSITION DATA

State _____ Zone _____

X _____

Y _____

Estab. By _____
Agency

Signature [Signature]

Title Land Surveyor

Division _____

Headquarters _____

Date 6/83 7100-52-(3/68)

CORNER RECORD (PERPETUATION)

MONUMENT : DESCRIBE NEW MONUMENT SET, OR WORK DONE TO PRESERVE EXISTING MONUMENT

Set RM-2½" Aluminum pipe with a 2½" Aluminum cap 20" in ground.
RM is S21-48-53W-2.70 ft. from corner.

ACCESSORIES : DESCRIBE NEW BT'S WITNESS OBJECTS ETC. ESTABLISHED, OR WORK DONE TO PRESERVE EXISTING EVIDENCE

18" D-Fir N76W-56.6 ft. scribed T3NR36ES26BT and with a 1" Brass disk stamped PLS 896.
20" D-Fir N1E-24.4 ft. scribed T3NR36ES25BT and with a 1" Brass disk stamped PLS 896.

Work Done By Larry D. Bishop Title Surveyor Date 6/83 State Registration No. 896
or Agency _____
Certified Cor. Record Prepared ? Yes No Filed At: _____ Date _____

REMARKS

Set guard posts East & South with signs 54-4 and 54-2.
Nailed 54-4 and BT signs to BT's and painted band and blazes red.

Index File No. T.3N R.36E M. Tract or Surv. No. CorSection 13

USDA-FOREST SERVICE

Index

File No. V-21

CORNER RECORD (SEARCH)

(Ref. FSM 7151.4)

Tract or

Cor.

Survey No. _____

No. _____


T 3N R. 36E

R.D. WALLA WALLA County UMATILLA

Merid. WILL

N.F. UMATILLA State OREGON

CORNER DIAGRAM

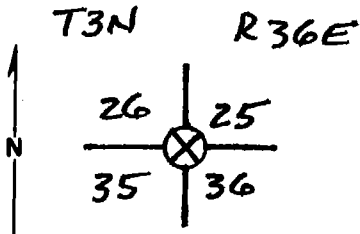

DESCRIBE CORNER MONUMENT FOUND

1 ORIG. 5" CORNER TREE IS NOW 26" & HAS A SINGLE HEALED BLAZE ON SOUTH EA SIDE.

DESCRIBE BEARING TREES OR OTHER OFFICIAL ACCESSORIES FOUND

2 ORIG. 8" FIR IS NOW A 24" BROKEN STUMP PREVIOUSLY OPENED WITH FULL SCRIBES VISIBLE. BEARS N50°E, 52⁰ FT.

3 ORIG. 12" FIR IS NOW 28" WITH A SINGLE HEALED BLAZE BEARS S18°E, 92⁰ FT.

4 ORIG. 10" FIR IS NOW 26" WITH A SINGLE HEALED BLAZE. BEARS S61°W, 66⁰ FT. (VISIBLE FROM RIDGETOP)

DESCRIBE CORNER LOCATION RELATIVE TO NEAR-BY FEATURES, ALSO HOW TO REACH CORNER

5 PLACED A "K" TAG AT END OF B.C.C. LOGGING ROAD 660 FT SOUTH OF CORNER.

PHOTO IDENTIFICATION DATA

Photo No. _____

Filed At. _____

Object Ident. _____

Ident. By _____

Signature

PLANE COORDINATE POSITION DATA

State _____ Zone _____

X _____

Y _____

Estab. By _____

Agency

Signature

Title

Division

Headquarters

Date

7100-52 (3. 68)

Dennis L. Gaylord

PLS 1636

6-24-82

CORNER RECORD (PERPETUATION)

MONUMENT : DESCRIBE NEW MONUMENT SET, OR WORK DONE TO PRESERVE EXISTING MONUMENT

ACCESSORIES : DESCRIBE NEW BT¹/₂ WITNESS OBJECTS ETC. ESTABLISHED, OR WORK DONE TO PRESERVE EXISTING EVIDENCE

Work Done By _____ Title _____ Date _____ State Registration No. _____
or Agency _____

Certified Cor. Record Prepared ? Yes No Filed At: _____ Date _____

REMARKS

Index File No. T. R. M. Tract or Surv. No. Cor.