


CERTIFIED RECORD OF LAND CORNER MONUMENTATION

History of original corner establishment:

Corner originally Monumented by William H. Odell under contract No. 114 in 1866 and reestablished by William E. Campbell under contract No. 918 in 1900, set Ironstone, 10"X6"X5", above ground, stone mound, Fir, 6" diam, N.10°E., 35 links  
 Fir, 8" diam., N.20°W., 56 links  
 Note: No restoration notes appear in county records.

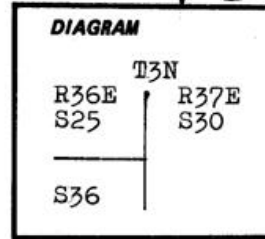


Description of corner evidence found:

Cornerstone, no marks, in a rock mound  
 S30  
 Corner S31 <sup>CC</sup> T.3N., R.37E., bears S.0°34'06"W., 141.34 feet,  
 (Record N.1°42'W., 155.1 feet.)



Description of monument and accessories established to perpetuate the original location of this corner:

Set a 2 1/2" diam. brass cap in a 2"X30" iron pipe at corner and buried cornerstone alongside pipe. Raised rock mound.

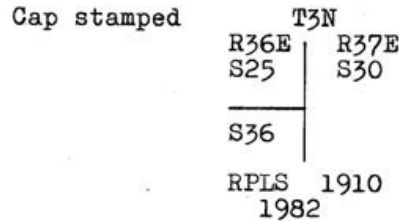

20" D.B.H. Douglas Fir, S.12°W., 73.4',  
 scribed T3NR36ES36BT  
 22" D.B.H. Douglas Fir, N.6 1/2°W., 122.6',  
 scribed T3NR36ES25BT  
 Both B.t's. have brass washers marked RPLS  
 1910 between B&T, red painted bands, B.T. tags and  
 attention signs. Steel fence posts 4.0'+ South and  
 West of Corner with attention, monument and boundary signs attached.

 State of Oregon, I hereby certify that the within instrument was filed in this office  
 for record on the 15th day of December, 1982  
David H. Kramlein by Betty L. Shatto  
 (COUNTY OFFICIAL) (DEPUTY)

82-107-R