

USDA-FOREST SERVICE

Index

File No. Z-19

CORNER RECORD (SEARCH)

(Ref. FSM 7151.4)

Tract or

Survey No. \_\_\_\_\_

Cor.

No. \_\_\_\_\_

T 3N R. 36E

R.D. Walla Walla

County Umatilla


Merid. Willamette

N.F. Umatilla

State Oregon

CORNER DIAGRAM

Sec. 36

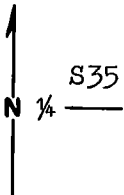

DESCRIBE CORNER MONUMENT FOUND

DESCRIBE BEARING TREES OR OTHER OFFICIAL ACCESSORIES FOUND

Orig. 12" now 30" D-Fir down with scribing on previously opened face "S35BT" S70E-9.2 ft..

PHOTO IDENTIFICATION DATA

Photo No. \_\_\_\_\_

Filed At. \_\_\_\_\_

Object Ident. \_\_\_\_\_

Ident. By \_\_\_\_\_

*Signature*

PLANE COORDINATE POSITION DATA

State \_\_\_\_\_ Zone \_\_\_\_\_

X \_\_\_\_\_

Y \_\_\_\_\_

Estab. By \_\_\_\_\_

*Agency*

DESCRIBE CORNER LOCATION RELATIVE TO NEAR-BY FEATURES, ALSO HOW TO REACH CORNER

After crossing the East line of Section 36 take the first left fork in Boise Cascade logging road to old Jeep road Northwest. Follow old Jeep road to top of ridge. Go down North side of ravine which bears S40W approx. 3500 feet to corner on edge of timber.

*Signature*

*Larry D. Bushong*

Title

Land Surveyor

Division

Headquarters

Date

6/83

7100-52-(3-68)

**CORNER RECORD (PERPETUATION)**

**MONUMENT : DESCRIBE NEW MONUMENT SET, OR WORK DONE TO PRESERVE EXISTING MONUMENT**

Set 2½"x30" Aluminum pipe with a 2½" Aluminum cap 26" in ground.

**ACCESSORIES : DESCRIBE NEW BT'S WITNESS OBJECTS ETC. ESTABLISHED, OR WORK DONE TO PRESERVE EXISTING EVIDENCE**

R/R spike driven horizontal into point of rock outcrop 18" above ground N30W-74.6 ft..  
26" D-Fir N40E-72.6 ft. scribed ¼S35BT and with a 1" Brass disk stamped PLS 896.

Work Done By Larry D. Bishop Title Surveyor Date 6/83 State Registration No. 896  
or Agency \_\_\_\_\_

Certified Cor. Record Prepared ? Yes No  Filed At: \_\_\_\_\_ Date \_\_\_\_\_

**REMARKS**

Set guard post West with sign 54-4.  
Nailed 54-4 and BT signs to BT and painted band and blaze red.


USDA-FOREST SERVICE

Index  
File No. Z-19  
T 3N R. 36E  
Merid. Will

CORNER RECORD (SEARCH)  
(Ref. FSM 7151.4)

Tract or Survey No. \_\_\_\_\_ Cor. No. \_\_\_\_\_  
R.D. WALLAWALLA County UMATILLA  
N.F. UMATILLA State OREGON

CORNER DIAGRAM

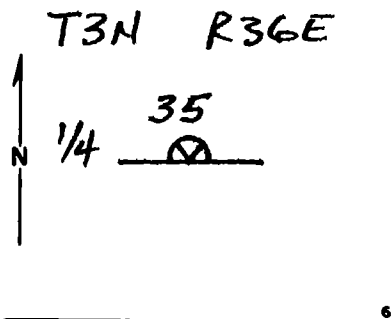

DESCRIBE CORNER MONUMENT FOUND

NONE

DESCRIBE BEARING TREES OR OTHER OFFICIAL ACCESSORIES FOUND

Down 36" FIR w/ SINGLE HEALED BLAZE. I OPEN & FIND SCRIBING & REVERSE, "1/4 S35 BT"  
AN E-W BLAZED LINE RUNS 50' ± SOUTH OF THIS B.T. (ORIGINAL BLAZED LINE). THIS B.T. IS JUST NORTH OF SMALL CREEK - UPHILL OF A LARGE COTTONWOOD TREE.

PHOTO IDENTIFICATION DATA

Photo No. \_\_\_\_\_  
Filed At. \_\_\_\_\_  
Object Ident. \_\_\_\_\_  
Ident. By \_\_\_\_\_  
*Signature*

DESCRIBE CORNER LOCATION RELATIVE TO NEAR-BY FEATURES, ALSO HOW TO REACH CORNER

THIS MAY NOT BE THE B.T. OF RECORD:  
① TREE TOO LARGE IN SIZE - ONLY 4" OF OVERGROWTH OVER SCRIBING.  
② TREE IS SCRIBED S35  
③ BLAZED LINE IS SOUTH OF B.T.  
COULD FIND NO EVIDENCE OF ANOTHER B.T.

PLANE COORDINATE POSITION DATA

State \_\_\_\_\_ Zone \_\_\_\_\_  
X \_\_\_\_\_  
Y \_\_\_\_\_  
Estab. By \_\_\_\_\_  
*Agency*

*Signature* Dennis L. Gaylord *Title* PLS 1636 *Division* \_\_\_\_\_ *Headquarters* \_\_\_\_\_ *Date* 7-8-82 7100-52 (3.68)

**CORNER RECORD (PERPETUATION)**

**MONUMENT : DESCRIBE NEW MONUMENT SET, OR WORK DONE TO PRESERVE EXISTING MONUMENT**

**ACCESSORIES : DESCRIBE NEW BT's WITNESS OBJECTS ETC. ESTABLISHED; OR WORK DONE TO PRESERVE EXISTING EVIDENCE**

Work Done By \_\_\_\_\_ Title \_\_\_\_\_ Date \_\_\_\_\_ State Registration No. \_\_\_\_\_  
or Agency \_\_\_\_\_ 10

Certified Cor. Record Prepared ? Yes No Filed At: \_\_\_\_\_ Date \_\_\_\_\_ 11

**REMARKS**

Index File No. T. R. M. Tract or Surv. No. Cor. 12  
13