

CERTIFIED RECORD OF LAND CORNER MONUMENTATION


HISTORY OF ORIGINAL CORNER ESTABLISHED:

Corner originally established in 1986 by Victor McLind.
Umatilla County Monumentation Record 86-96-R states:

Set a 2" x 30" aluminum pipe with 2 1/2" aluminum cap, marked as shown above, 24" in ground, from which:
A Spruce, 8" diam., scribed C 1/4 S1 BT, bears S37 1/2° E, 11.2 ft.
A Fir, 12" diam., scribed C 1/4 S1 BT, bears S34°W, 22.0 ft.

Set a steel post 3" South of corner, with sign 54-4.

T 3 N R 37 E C-23

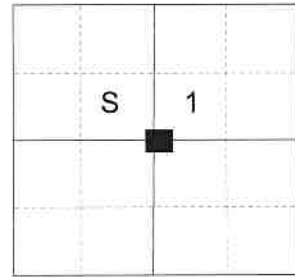

DESCRIPTION OF CORNER EVIDENCE FOUND:

Found a 2 1/2" aluminum pipe, 3" above ground with 2 1/2" aluminum cap marked as shown, from which:

A 14" Spruce bears South 37° East a dist. of 11.20 ft., alive and vigorous with healed blaze.

A 17" White Fir bears South 34° West a dist. of 22.00 ft., alive and vigorous with healed blaze.

The terminus of a Northerly bearing fence line bears approx. 0.5 ft. West.

DESCRIPTION OF MONUMENT AND ACCESSORIES I ESTABLISHED TO PERPETUATE THE ORIGINAL LOCATION OF THIS CORNER:

From the aluminum pipe monument:


NEW BEARING OBJECTS:

A 9" White Fir bears North 6° East a dist. of 24.20 ft., marked C 1/4 S1 BT.
A 10" Spruce bears West a dist. of 7.85 ft., marked C 1/4 S1 BT.

I hereby certify that the corner was perpetuated on June 26, 2019.
Witness: Kyle A. Tucker



Renewal Date: June 30, 2021

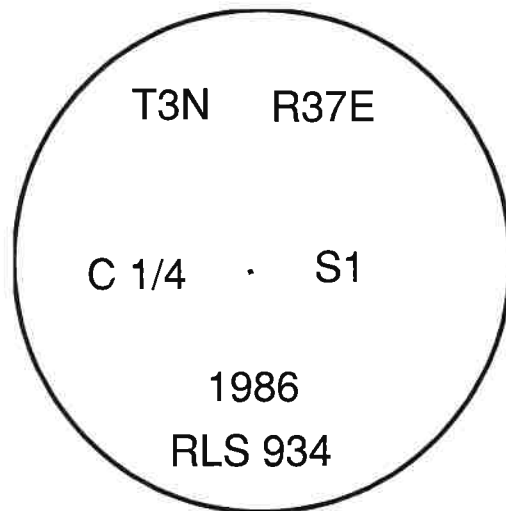

RECEIVED BY
Umatilla County Surveyor
Date: 7/18/19
Rec'd By: CT
No.: 19-070-R

I used a steel tape and magnetic compass in the establishment of the new accessories. I used 13° East declination, the distances are to a 60d spike driven into the right side of the root crown of the bearing trees. A brass washer marked OPLS 83571 is attached to the BT blaze of the new bearing trees.