

**CERTIFIED RECORD OF LAND CORNER MONUMENTATION**


**HISTORY OF ORIGINAL CORNER ESTABLISHED:**

Corner originally established in 1986 by Victor McLind.  
Umatilla County Monumentation Record 86-97-R states:

Set a 2" x 30" aluminum pipe with 2 1/2" aluminum cap, marked as shown above, 24" in ground, from which:  
A Fir, 14" diam., scribed "CE 1/16 S1 BT" bears N 46 1/4° E, 70.2 ft.  
A Fir, 13" diam., scribed "CE 1/16 S1 BT" bears N 82 1/2° W, 40.0 ft.

Set a steel post 3' South of corner, with sign 54-4.

T 3 N R 37 E C-24

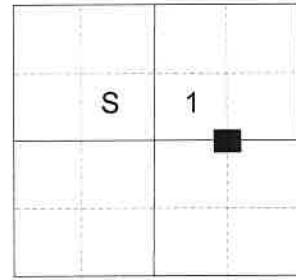

**DESCRIPTION OF CORNER EVIDENCE FOUND:**

Found a 2 1/2" aluminum pipe, flush with ground and 2 1/2" aluminum cap marked as shown, from which:

A 15" Fir stump bears North 46° East a dist. of 70.20 ft., standing 6' tall with healed blaze.

A 15" Fir stump bears North 82° West a dist. of 40.00 ft., standing 6' tall with healed blaze.

Steel fencepost bears South approx. 0.5'.

**DESCRIPTION OF MONUMENT AND ACCESSORIES I ESTABLISHED TO PERPETUATE THE ORIGINAL LOCATION OF THIS CORNER:**

From the aluminum pipe monument:


**NEW BEARING OBJECTS:**

A 16" White Fir bears North 79° East a dist. of 3.25 ft., marked CE 1/16 S1 BT.  
A 7" White Fir bears South 64° West a dist. of 8.60 ft., marked CE 1/16 S1 BT.

I hereby certify that the corner was perpetuated on July 8, 2019.  
Witness: Kyle A. Tucker



Renewal Date: June 30, 2021

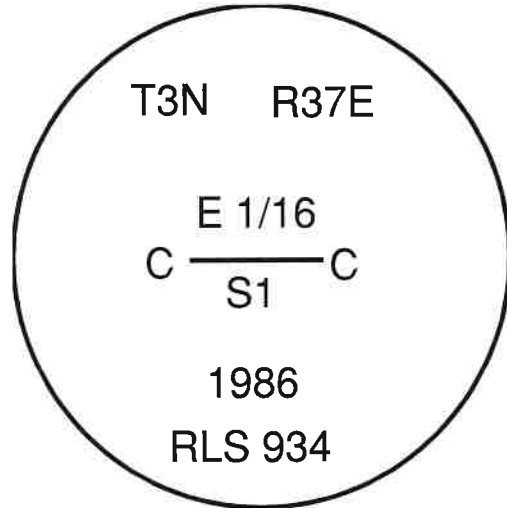

**RECEIVED BY**  
Umatilla County Surveyor  
Date: 7/18/19  
Rec'd By: CT  
No.: 19-072-R

I used a steel tape and magnetic compass in the establishment of the new accessories. I used 13° East declination, the distances are to a 60d spike driven into the right side of the root crown of the bearing trees. A brass washer marked OPLS 83571 is attached to the BT blaze of the new bearing trees.