

CERTIFIED RECORD OF LAND CORNER MONUMENTATION


**HISTORY OF ORIGINAL CORNER ESTABLISHED:**

Corner originally established in 1986 by Victor McLind.  
Umatilla County Monumentation Record 86-99-R states:

Set a 2" x 30" aluminum pipe with 2 1/2" aluminum cap, marked as shown above, 24" in ground, from which:  
A larch, 8" diam., scribed "CS 1/16 S1 BT" bears S 53 1/2° E, 33.7 ft.  
A larch, 9" diam., scribed "CS 1/16 S1 BT" bears S 57 3/4° W, 8.5 ft.

Set a steel post 3' South of corner, with sign 54-4.

T 3 N R 37 E D-23

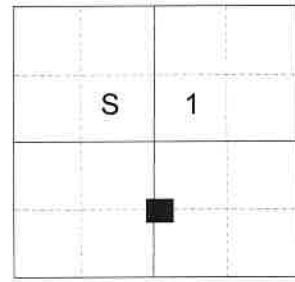

**DESCRIPTION OF CORNER EVIDENCE FOUND:**

Found a 2 1/2" aluminum pipe, 2" above ground with 2 1/2" aluminum cap marked as shown, from which:

An 18" Tamarack bears South 60° West a dist. of 8.50 ft., alive and vigorous with healed blaze.

A 15" x 6' Tamarack stob bears South 55° East a dist. of 33.70 ft., dead and standing with healed blaze.

Steel fencepost bears South 5'

**DESCRIPTION OF MONUMENT AND ACCESSORIES I ESTABLISHED TO PERPETUATE THE ORIGINAL LOCATION OF THIS CORNER:**


From the aluminum pipe monument:

**NEW BEARING OBJECTS:**

A 4" White Fir bears South 57° East a dist. of 22.10 ft., marked X BT.

I hereby certify that the corner was perpetuated on June 26, 2019.

Witness: Kyle A. Tucker

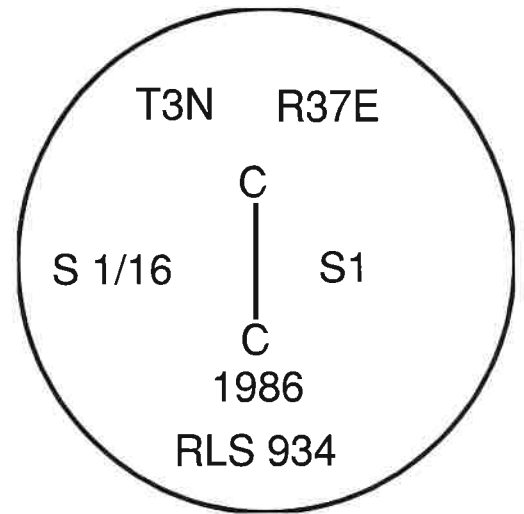

REGISTERED  
PROFESSIONAL  
LAND SURVEYOR



OREGON  
June 2, 2010  
JEFFREY S. HSU  
83571

Renewal Date: June 30, 2021

I used a steel tape and magnetic compass in the establishment of the new accessories. I used 13° East declination, the distances are to a 60d spike driven into the right side of the root crown of the bearing trees. A brass washer marked OPLS 83571 is attached to the BT blaze of the new bearing trees.

**RECEIVED BY**

Umatilla County Surveyor

Date: 7/18/19

Rec'd By: CT

No.: 19-071-R