

Index _____

File No. E-257

CORNER RECORD (SEARCH)

(Ref. FSM 7151.4)

Tract or Survey No. _____ Cor. No. _____


T 3N R. 37E

R.D. Walla Walla County Umatilla

Merid. Willamette

N.F. Umatilla State Oregon

CORNER DIAGRAM

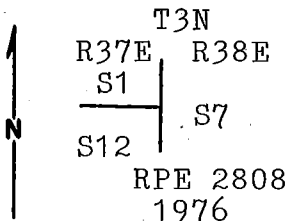

DESCRIBE CORNER MONUMENT FOUND

Found $2\frac{1}{2}$ " brass cap on $2\frac{1}{2}$ " galv. iron pipe projecting 3" out of a stone mound.

DESCRIBE BEARING TREES OR OTHER OFFICIAL ACCESSORIES FOUND

A down 32" ponderosa pine bears N 18° E, 33.7' to root hole with previously opened blaze. (Original BT).
 A 26" ponderosa pine bears S 70° E, 72.5' with healed blaze. (Original BT).

PHOTO IDENTIFICATION DATA

Photo No. _____

Filed At. _____

Object Ident. _____

Ident. By _____

Signature

A 18" douglas fir bears S 20° W, 61.0' with healed double blaze. (RPE 2808 BT). A 12" douglas fir bears N 10° W, 33.0' with partly healed dbl. bl. (RPE 2808 BT).

DESCRIBE CORNER LOCATION RELATIVE TO NEAR-BY FEATURES, ALSO HOW TO REACH CORNER

Corner is located on a steep east slope about 130' east of a north-south spur ridge.

PLANE COORDINATE POSITION DATA

State _____ Zone _____

X _____

Y _____

Estab. By _____

Agency

Signature

Will R. Wells

Title
PLS

Division

Headquarters
Pendleton, OR

Date
9/17/91 FS-7100-52 (3/68)

CORNER RECORD (PERPETUATION)

MONUMENT: DESCRIBE NEW MONUMENT SET, OR WORK DONE TO PRESERVE EXISTING MONUMENT

Maintained existing corner monument by cleaning up around corner. Set steel fence post to north with signs 54-2 and 54-9 attached.


ACCESSORIES : DESCRIBE NEW BT'S WITNESS OBJECTS ETC. ESTABLISHED, OR WORK DONE TO PRESERVE EXISTING EVIDENCE

Marked 1 new bearing tree:
A 10" ponderosa pine bears S 70 $\frac{1}{2}$ ⁰W, 18.1' scribed T3N R37E S12 BT.
New bearing tree has a brass washer stamped PLS 1106 nailed to face of blaze. Attached signs 54-3 and 54-9 and painted face of blaze and a 6" red band around all bearing trees.

Work Done By W.R. Wells Title BLS Date 9/17/91 State Registration No. 1106
or Agency
Certified Cor. Record Prepared? Yes No Filed At: Umatilla Co. Surveyor Off Date 12/31

REMARKS

Index
 File No. E 25 **CORNER RECORD (SEARCH)** Tract or _____ Cor. _____
 (Ref. FSM 7151.4) Survey No. _____ No. E 25
 T 3 N R. 37 E R.D. Pendleton County Umatilla
 Merid. Willamette N.F. Umatilla State Oregon

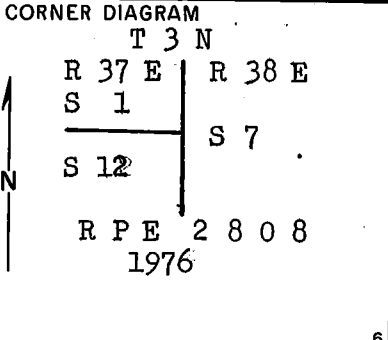

DESCRIBE CORNER MONUMENT FOUND

NONE

DESCRIBE BEARING TREES OR OTHER OFFICIAL ACCESSORIES FOUND

A pine 32" diam. bears N 18° E., 33.66 ft. (51 lks) with a healed blaze. When opened found axe marks but no scribing.

A pine 26" diam. bears S. 70° E., 70.6 ft. (107 lks) with a partially healed blaze. No visible scribing.

PHOTO IDENTIFICATION DATA

Photo No. _____
 Filed At. _____
 Object Ident. _____
 Ident. By _____
Signature

DESCRIBE CORNER LOCATION RELATIVE TO NEAR-BY FEATURES, ALSO HOW TO REACH CORNER

Westerly from west edge of Tollgate 3.5 miles to road south between metal snow fence- Thence southerly 1.2 miles to creek crossing and road forks- Thence on left fork 0.9 miles to Reforestation Project P36 sign- Thence northeasterly 0.2 miles to location tag which indicates 1/4 corner is north 830 ft. Corner is south 1800 feet about 200 ft. below break of hill.

PLANE COORDINATE POSITION DATA

State _____ Zone _____
 X _____
 Y _____
 Estab. By _____
Signature Agency _____

James O. Hawley Title RPE Division 2808 Headquarters _____ Date 7/28/76 7100-52 (3/68)

CORNER RECORD (PERPETUATION)

MONUMENT: DESCRIBE NEW MONUMENT SET, OR WORK DONE TO PRESERVE EXISTING MONUMENT

Set a 2 $\frac{1}{2}$ " brass cap on 2" iron pipe 31" long 10" above ground in earth and rock mound with 6' steel fence post 4' south with sign 54-4 attached.

9

ACCESSORIES : DESCRIBE NEW BT's WITNESS OBJECTS ETC. ESTABLISHED, OR WORK DONE TO PRESERVE EXISTING EVIDENCE

A fir 7" diam. bears N 10° W., 32.0 ft. dist. marked T 3 N R 37 E S 1 BT
 A fir 12" diam. bears S 20° W., 61.0 ft. dist. marked T 3 N R 37 E S 12 BT

Each BT has a sign 54-3 attached 6" below a band of red paint and has a brass washer marked RPE 2808 nailed flush with BT blaze.

10

Work Done By: James D. Hanley Title: Engineer Date: 8/28/76 State Registration No. ORPE 2808
 or Agency
 Certified Cor. Record Prepared? Yes No Filed At: Pendleton, Oregon Date 8/ /76

11

REMARKS

When this corner was set in 1878 by George S. Pershin it was called the corner to sections 1, 12, 6 & 7 but in 1899 when John W. Kimbrell surveyed T 3 N R 38 E he found the corner to sections 6 & 7 to be 9.65 chains north of Pershin's location. Kimbrell consequently set his corner to sections 6 & 7 and destroyed the references to said sections on Pershin's section corner. Therefore, the two pine BT's are believed to be Pershin's original bearing trees.

12

Index File No. E 25 T. 3 N R. 37 E W.M. Tract or Surv. No. Cor. 13.