


LAND CORNER RECORD

44 5680-2

1. T 3N R 37E No. J 13 Cor. Sec. Mer. Will State Oregon (Rectangular) N. F. Umatilla Dist. Pendleton 9

2. Corner Status

3. Original Description Resurvey Vol. 192 Page 19 Where Recorded GLO year 1879

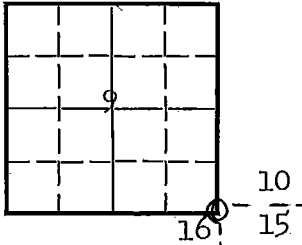

4. Description of Corners: Resurvey set fir post 4" square 4" in mound of stone on S.W. face of spur for corner to section 9, 10, 15 & 16. No trees near.

7. Photo Identification
Photo No. UM 336-3
Ident. By: _____

5. Investigation Notes: Found what may be 4" sq. fir post for sec. cor. 9, 10, 15, 16. We found a dead post which is the right length and possibly was 4" sq. at the time the corner was set. Couldn't find any evidence of a mound of stone because of soil erosion in the area. No natural means for this stake to be in the area. We tied orange ribbon and painted silver on a 8 1/2 x 4 1/2' rock we found beside the stake. Stake was on south side of rock 2" away. Take ridge between the first forks of Lick Creek, go approx. 1/4 mile past salt ground No. 5. Rock will be on S.W. face of slope.

8. Plane Coordinate Position Data
State _____ Zone _____
X _____
Y _____
Estab. By _____
Field Book No. _____
Where Filed _____

9. Evaluation
Authentic _____
Needs Verif. X Monument NO
Re-estab. _____ Survey _____
Land Status _____

6. Signed A. Galbraith Title Range Tech. Date 5-8-64 gl

PERPETUATION RECORD

10. Monument:

11. Accessories

Field Book _____ Page _____

12. Set By _____ Title _____
License _____ Agency _____ Date _____

13. Recorded By _____ Volume _____ Page _____
(Agency)

(Date) (City) (County) (State)

14. Remarks:

J-13