


USDA-FOREST SERVICE

Index File No. Z-01 **CORNER RECORD (SEARCH)** (Ref. FSM 7151.4) Tract or Survey No. _____ Cor. No. _____
 T 3N R. 38E R.D. WALLA WALLA County UMATILLA
 Merid. WILLAMETTE N.F. UMATILLA State OREGON

CORNER DIAGRAM

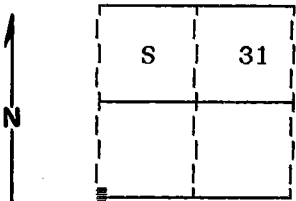

DESCRIBE CORNER MONUMENT FOUND

Found a stone 19x11x7 inches with chisel marks visible.

DESCRIBE BEARING TREES OR OTHER OFFICIAL ACCESSORIES FOUND

Found a 36 inch diameter Ponderosa Pine stump N31°E, 175 lks with scribes visible.

PHOTO IDENTIFICATION DATA

Photo No. _____
 Filed At. _____
 Object Ident. _____
 Ident. By _____
Signature

DESCRIBE CORNER LOCATION RELATIVE TO NEAR-BY FEATURES, ALSO HOW TO REACH CORNER

Corner falls on a sage brush flat approximately 150 feet East of Forest Road 3150-105

PLANE COORDINATE POSITION DATA

State _____ Zone _____
 X _____
 Y _____
 Estab. By _____

Signature _____
 Agency _____

Title SURVEYOR Division _____ Headquarters _____

Date 9-6-91 FS-7100-52 (3/68)

6

7

8

2

3

4

5

CORNER RECORD (PERPETUATION)

MONUMENT: DESCRIBE NEW MONUMENT SET, OR WORK DONE TO PRESERVE EXISTING MONUMENT

Set a 2½"x30" aluminum pipe with aluminum cap marked as shown:
 Pipe is set 20 inches in the ground.
 Raised a mound of stone around monument, 4 ft. base to top of cap.
 Buried the original corner stone East and alongside of monument.

R37E	R38E	
	T3N	
	S 31	
S 1	S 6	CC
	T2N	
1991 OPLS 644		

ACCESSORIES : DESCRIBE NEW BT'S WITNESS OBJECTS ETC. ESTABLISHED, OR WORK DONE TO PRESERVE EXISTING EVIDENCE

New BTs and B0:

A 12 inch diam. Douglas Fir bears N3°E, 185.3 feet marked T3N R38E S31 CC BT
 A 16 inch diam. Douglas Fir bears S67°E, 218.0 feet marked T2N R38E S6 CC BT
 A 5/8"x30" iron pin with plastic cap marked BGA SURVEY MARKER bears West, 4.13 feet
 A 25 inch diam. Douglas Fir bears N75°E, 125.9 feet marked X BT
 Attached Bearing Tree and Land Survey Monument signs to the BTs
 Set a steel fencepost approximately 5 feet East with Land Survey Monument sign attached.

Work Done By D.I. Griffith Title Surveyor Date 8-13-91 State Registration No. OPLS 644
 or Agency

Certified Cor. Record Prepared ? Yes No Filed At: Umatilla Co. Surveyor Off. Date 10-91

REMARKS

Witness: Jeff Petersen

Index File No. Z-01 T.3U R.38E W.M. Tract or Surv. No. Cor.

USDA-FOREST SERVICE

Index

File No. Z-1

CORNER RECORD (SEARCH)

(Ref. FSM 7151.4)

Tract or

Survey No.

Cor.

No.

T 3N R. 38E

R.D. Walla Walla


County Umatilla

Merid. Will

N.F. Umatilla

State Oregon

CORNER DIAGRAM

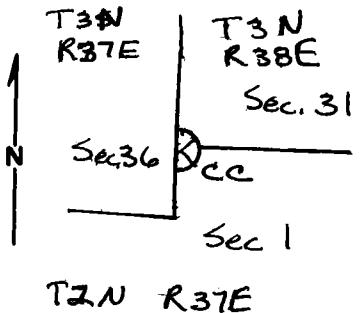

DESCRIBE CORNER MONUMENT FOUND

Stone was ~~not~~ found in mound of stones. It ~~was~~ is basalt 20x12x7 in with marks visible and an "N" discernible.

DESCRIBE BEARING TREES OR OTHER OFFICIAL ACCESSORIES FOUND

Orig. 58" fir is now a dead snag with scribing visible and bears N31° E, 115 ft from corner.

PHOTO IDENTIFICATION DATA

Photo No. _____
 Filed At. _____
 Object Ident. _____
 Ident. By _____
 Signature _____

DESCRIBE CORNER LOCATION RELATIVE TO NEAR-BY FEATURES, ALSO HOW TO REACH CORNER

Put up BT sign which is visible from road 3150 105.

PLANE COORDINATE POSITION DATA

State _____ Zone _____
 X _____
 Y _____
 Estab. By _____
 Agency _____

Signature Cathy M. McQuine Title Volunteer

Division _____ Headquarters SO

Date 9/6/84

7100-52-(3,68)

CORNER RECORD (PERPETUATION)

MONUMENT : DESCRIBE NEW MONUMENT SET, OR WORK DONE TO PRESERVE EXISTING MONUMENT

9

ACCESSORIES : DESCRIBE NEW BY'S WITNESS OBJECTS ETC. ESTABLISHED, OR WORK DONE TO PRESERVE EXISTING EVIDENCE

10

Work Done By _____ Title _____ Date _____ State Registration No. or Agency _____

Certified Cor. Record Prepared ? Yes No Filed At: _____ Date _____

11

REMARKS

12

Index File No. T. R. M. Tract or Surv. No. Cor.

13