

CORNER RESTORATION FORM

Township 4N Range 28E Section 21,22 County UMATILLA
 State OREGON Date 5-1-2019 Number P-1

Corner Designation: SECTION 21,22

Previous Renewals ORIGINAL SOURCE OF CORNER

ORIGINALLY SURVEYED IN 1860 BY HAFT UNDER CONTRACT #93.

DEPENDENT SURVEY BY GOULD IN 1941.

Accessories Found:

NONE

Condition Report Only

Not Found

Renewed

Surveyed In


Referenced

MONUMENT DETAIL

Found Set

BASIS OF BEARINGS, NAD 83/91 OREGON STATE PLANE
 COORDINATES NORTH ZONE:

NORTHING: 784809.69
 EASTING: 8489591.18

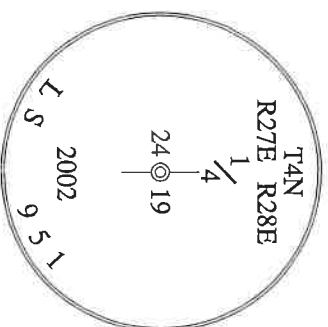

Monument & Accessories Set (Procedure and Description)

FOUND 2 3/8" BRASS CAP, 3" DEEP AS PER COUNTY SURVEY 11-137-B

SET 1 1/2" STEEL WASHER MARKED 61420, IN POWER POLE w/MAG NAIL APPROX. 2' ABOVE GRADE, N08°54'W, 91.54 FT.

CHISELED "X" IN SOUTHWEST LEG OF CENTER PIVOT, APPROX. 2' ABOVE GRADE, N09°01'E, 361.44 FT.

SET 1 1/2" STEEL WASHER MARKED 61420, IN POWER POLE w/MAG NAIL APPROX. 2' ABOVE GRADE, S02°55'W, 212.16 FT.

SET 1 1/2" STEEL WASHER MARKED 61420, IN RR TIE w/MAG NAIL APPROX. 2' ABOVE GRADE, S72°45'E, 25.08 FT. PLACED A NEARBY

SURVEY MARKER SET ON POST.

Sketch of Monument, Accessories and General Area

REGISTERED PROFESSIONAL LAND SURVEYOR

Lance Clark King

OREGON
MAY 10, 2011
LANCE CLARK KING
61420

RENEWALS: 6/30/2021

Agency: CK3, LLC
 945 W. ORCHARD
 HERMISTON OREGON 97838
 OFFICE: 541-567-2345
 FAX: 541-567-2305
 WEB: CK3L.C.NET
 Field Book # 0-325

COUNTY SURVEYOR RECORDING INFO

Received _____

Filed _____

Survey No. _____

Drawing No. _____

Index No. P-1

19-080-C