

CORNER RESTORATION FORM

Township 4N Range 28E Section 21, 22 County UMATILLA
 State OREGON Date 6-12-2019 Number P-13

Corner Designation: 21, 22

Previous Renewals ORIGINAL SOURCE OF CORNER

ORIGINALLY SURVEYED IN 1860 BY HAFT UNDER CONTRACT #93, HE SET POST IN MOUND

WITH TRENCH, MADE PTS AND DEPOSITED A PINT OF CHARCOAL.

Accessories Found: _____

FOUND 2 1/2" BRASS CAP WITNESS CORNER AS PER P-13-92-045C, S89°03'W, 14.83 FT.

Condition Report Only


- Not Found
 Renewed
 Surveyed In
 Referenced

MONUMENT DETAIL

Found Set

BASIS OF BEARINGS, NAD 83/91 OREGON STATE PLANE
 COORDINATES NORTH ZONE:

NORTHING: 784892.16
 EASTING: 8505256.10

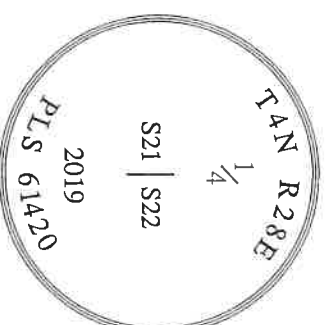

Monument & Accessories Set (Procedure and Description)

- SET 2 1/2" BRASS CAP 7" BELOW GRADE w/SURVEY MARKER SIGN ON GREEN STEEL POST, AS PER P13-92-45C & 18-021-B.
- SET 1 1/2" STEEL WASHER MARKED 61420, ON SOUTH POWER POLE OF DOUBLE POWER POLE w/MAG NAIL, N110°00'W, 204.16 FT.
- SET 5/8" x 10" REBAR w/RED PLASTIC CAP PLS 61420, IN FENCE LINE, N88°35'E, 96.10 FT.
- SET 1 1/2" STEEL WASHER MARKED 61420, ON POWER POLE w/MAG NAIL, S07°12'W, 248.67 FT.

Sketch of Monument, Accessories and General Area

**REGISTERED
PROFESSIONAL
LAND SURVEYOR**

Lance Clark King

**OREGON
MAY 10, 2011
LANCE CLARK KING
61420**

RENEWALS: 6/30/2021

Agency: CK3, LLC
 945 W. ORCHARD
 HERMISTON OREGON 97838
 OFFICE: 541-567-2345
 FAX: 541-567-2305
 WEB: CK3LLC.NET
 Field Book # 0-331

**COUNTY SURVEYOR
RECORDING INFO**

Received _____
 Filed _____
 Survey No. _____
 Drawing No. _____
 Index No. P-13

19-080-C