

OREGON CORNER RESTORATION FORM

SECTION 23 TOWNSHIP 4 NORTH RANGE 29 EAST R-17
COUNTY : UMATILLA DATE 8-98

CORNER DESIGNATION

SW CORNER

CONDITION REPORT ONLY
 NOT FOUND
 RENEWED
 UNCOVERED
 SURVEYED IN
 REFERENCED

PREVIOUS RENEWALS / SURVEYS, ETC.


ORIGINALLY SURVEYED IN 1861 BY DAVENPORT UNDER CONTRACT #101. HE SET A POST IN A MOUND OF EARTH AND A CHARRED STAKE.

MONUMENTS AND ACCESSORIES FOUND: CONDITION AND SOURCE

2 1/2" BRASS CAP WITNESS CORNER S 0'.17'31" W, 20.00 FEET SOUTH.

SKETCH

MONUMENT DETAIL

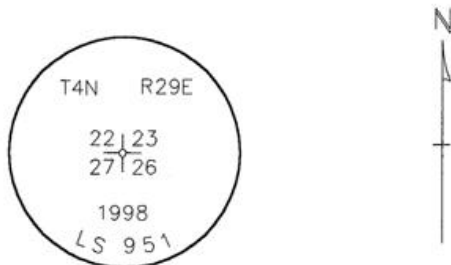

MONUMENT SET (PROCEDURES AND DESCRIPTION)

FROM A WITNESS CORNER I SET A 5/8" X 30" IRON REBAR WITH AN ALUMINUM CAP STAMPED AS ABOVE, N 0'.17'31" E, 20.00 FEET.

NEW ACCESSORIES FROM WHICH

AN ALUMINUM TAG #951 IN A POWER POLE LIES S 13'.38'30" W, 12.40 FEET.
AN ALUMINUM TAG #951 ON A BRACE POST LIES N 55'.15'40" E, 48.62 FEET.
AN ALUMINUM TAG #951 ON A POWER POLE LIES N 2'.22'30" E, 29.41 FEET.

LOCATION AND COMMENTS

COMPASS DEC.

SURVEYOR'S SEAL

RECEIVED BY
Umatilla County Surveyor
Date 10-98
Rec'd By JK
No. 98-213-C

FIRM/AGENCY
EDWARDS SURVEYING
P.O. BOX 763
HERMISTON, OREGON 97838
97838

PARTY CHIEF
D. EDWARDS

NOTES

WITNESS
RICK SMITH

REGISTERED
PROFESSIONAL
LAND SURVEYOR

G. Dennis Edwards

OREGON
JULY 16, 1971
G. DENNIS EDWARDS
951
RENEWS 12/31/99