


CERTIFIED RECORD OF LAND CORNER MONUMENTATION

History of original corner establishment:

Original corner set by Timothy W. Davenport, under GLO Contract No. 101, approved December 7, 1861.

Record states:
Set qr. sec. post in mound with charred stake as per instructions.

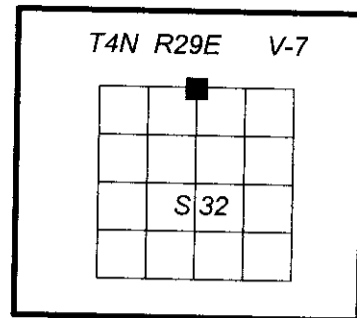

Subsequent Monumentation

Corner reestablished by Verl R. Fraley, LS 183, as described by County Survey No. Q-695-Ax, dated June 1, 1950, in the records of the Umatilla County Surveyor.

Record states:
Dug and found no trace of original corner.
Set 1 1/2" I.P. for N. 1/4 corner Sec. 32.

Corner remonumented by David H. Krumbein, LS 933, as described by County Survey No. I-26-B, dated June 21, 1974, in the records of the Umatilla County Surveyor.

Record states:
Found 1 1/2" I. Pipe.
Set brass cap.

Corner perpetuated by G. Dennis Edwards, LS 951, as described by County Survey No. 95-60-B, dated 3/95, in the records of the Umatilla County Surveyor.

Record states:
Original surveyor Davenport, 1861, #101. He set a post in mound with charred stake.
Fraley set 1 1/2" I. Pipe, 1950. Krumbein set 2 1/2" B.C. in place of Fraley I.P. in 1974.
Found Krumbein 2 1/2" B.C.
New accessories:
SE corner 4' x 12' conc. spring house, bears N32°06'10"W, 119.61 ft. dist.
1"x30" I. Pipe with 2 3/8" B.C., bears N89°51'10"E, 10.00 ft. dist.
Alum Tag #951 in P.Pole, bears S27°25'10"E, 59.58 ft. dist.
Alum Tag #951 in P.Pole, bears S52°56'10"W, 33.92 ft. dist.

Corner perpetuated by Brit L. Primm, LS 48509, as described by County Survey No. 02-49-G, dated 2/02, in the records of the Umatilla County Surveyor.


Record states:
Originally surveyed in 1861 by Davenport under Contract #101. He set a post in a mound of earth and a charred stake. In 1950 Fraley set a 1 1/2" Iron Pipe. In 1974 Krumbein set a 2 1/2" B.C. in place of Fraley Iron Pipe.
Monuments and accessories found:
An aluminum tag #951 on a power pole lies S27°27'51"E, 59.58 feet.
An aluminum tag #951 on a power pole fence post lies S52°53'24"W, 33.85 feet.
New Accessories from which:
A 5/8" x 30" iron rod with a yellow plastic cap mkd. PLS LS 48509, 1' below surface lies N69°13'50"W, 18.57 feet.
A 5/8" x 30" iron rod with a yellow plastic cap mkd. PLS LS 48509, 1' below surface lies N77°11'54"E, 23.83 feet.

Description of corner evidence found:

Found a 2 1/2 ins. diam. brass cap, firmly set, 9 ins. below the surface, in the middle of an E-W dirt road, mkd. as shown:

From the recovered monument I find the Edwards accessory:
An aluminum tag #951 on a power pole, bears S27 1/2° E, 59.6 ft. dist. and accessories mkd. by Primm:

A 5/8 ins. diam. iron rod with a yellow plastic cap mkd. PLS LS 48509, down 12 ins. below the surface, bears N. 77 1/4° E., 23.8 ft. dist.
A 5/8 ins. diam. iron rod with a yellow plastic cap mkd. PLS LS 48509, down 12 ins. below the surface, bears N. 69 1/4° W., 18.6 ft. dist.

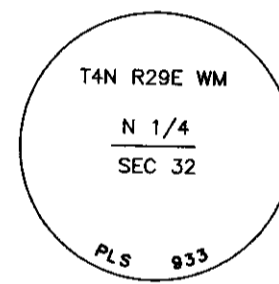

Description of monument and accessories I established to perpetuate original location of this corner:

New accessory:
A blue DEEP-1 magnet, buried 12 ins. below the surface, bears S. 37 1/2° W., 27.9 ft. dist.

NAD '83 autonomous C/A code geographic position:

Lat. 45°47'29.2" N
Long. 119°12'55.1" W

I hereby certify that the corner was monumented and accessories taken as described, using a staff compass, set with 15 1/2° East declination, and steel tape on November 15, 2013.

Witnesses: Kristina Powell and Kathy Bohms

REGISTERED
PROFESSIONAL
LAND SURVEYOR

[Signature]
OREGON
JANUARY 18, 1994
RON C. WALTER
2648

Renewal Date: June 30, 2014

Office of County Surveyor County of Umatilla
State of Oregon, I hereby certify that the within instrument was filed in this office
for record on the 18th day of December, 2013
Dave Krumbein by Gary Roberts
(COUNTY OFFICIAL) (DEPUTY)