


CERTIFIED RECORD OF LAND CORNER MONUMENTATION

History of original corner establishment:

Original corner set by Timothy W. Davenport, under GLO Contract No. 101, approved December 7, 1861.

Record states:

Set qr. sec. post in mound with charred stake as per instructions.

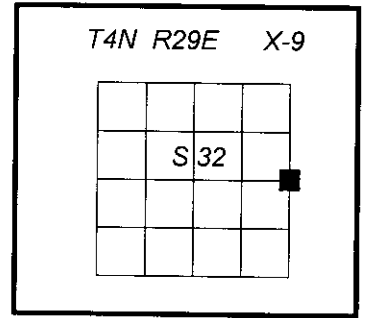

Subsequent Monumentation

Corner reestablished by Verl R. Fraley, LS 183, as described by County Survey No. Q-937-Ax, dated 1949, in the records of the Umatilla County Surveyor.

Record states:

Found 12"x12"x18" boulder 1 ft. under road surface. Found no markings on it. Set temp. point for E. 1/4 cor.

Set 1" I. Pin 8" under road surface just east and alongside 12"x12"x18" boulder for the E. 1/4 corner of Sec. 32.

References: Nail in P. Pole bears N. 60° W., dist. 32.1 ft.
Nail in P. Pole bears S. 45° E., dist. 34.4 ft.

Corner refurbished by Verl R. Fraley, LS 183, as described by County Survey No. Q-695-Ax, dated June 1, 1950, in the records of the Umatilla County Surveyor.

Record states:

Found a 5/8" I. Pin (East 1/4 Corner) which I established in 1949.

Corner remonumented by David H. Krumbein, LS 933, as described by County Survey No. I-26-B, dated June 21, 1974, in the records of the Umatilla County Surveyor.

Record states:

Found 1" Pin. Brass cap set.

Corner perpetuated by G. Dennis Edwards, LS 951, as described by County Survey No. 95-60-B, dated 3/95, in the records of the Umatilla County Surveyor.

Record states:

Original surveyor Davenport, 1861, #101. He set a post in mound with charred stake. Fraley 1949 set 5/8" I. Pin. Krumbein 1974 set B.C. in place of 5/8" I. Pin.

Found 2 1/2" B.C., 5" below surface.

Found 2 1/2" B.C. W.C., S61°02'40"E, 38.03 ft. (stamped 38.00')

See my 1994-1 county public monumentation survey.

New accessories:

- 1/2"x24" rebar with #951, bears N42°33'30"W, 43.25 ft. dist.
- 5/8"x30" rebar, p. cap #951, bears S63°22'30"W, 67.33 ft. dist.
- Alum. tag #951 in P. Pole, bears N57°31'30"E, 65.20 ft. dist.
- 2 1/2" B.C. 1974 38.00, bears S61°02'40"E, 38.03 ft. dist.

Corner perpetuated by Brit L. Primm, LS 48509, as described by County Survey No. 02-49-G, dated 2/02, in the records of the Umatilla County Surveyor.

Record states:

Originally surveyed in 1861 by Davenport under Contract #101. He set a post in a mound of earth and a charred stake. In 1949 Fraley set a 5/8" iron rod. In 1974 Krumbein set a B.C. in place of 5/8" iron rod.

Monuments and accessories found:

- A 1/2" x 24" iron rod with a yellow plastic cap mkd. #951 lies N42°38'08"W, 43.20 feet.
- An aluminum tag #951 on a poer [sic] pole lies N57°31'08"E, 65.19 feet.
- A 2 1/2" brass cap 1974 lies S61°02'52"E, 38.08 feet.

New Accessories from which:

- A 5/8" x 30" iron rod with a yellow plastic cap mkd. PLS LS 48509 lies S75°52'05"W, 61.27 feet.

Description of corner evidence found:

Found a 2 1/2 ins. diam. brass cap, firmly set, 5 ins. below the asphalt, in the intersection of S. Edwards Road and Harding Ave., mkd. as shown:

From the recovered monument I find the Krumbein accessory:

A 1 1/2 ins. diam. steel pipe with cap cut off, 2 ins. above ground, bears S. 61° E., 38.0 ft. dist., with guard post 1 ft. S'ly of monument.

and accessories mkd. by Edwards:

- An alum. tag #951 on P. Pole, bears N. 57 1/2° E., 65.2 ft. dist.
- A 1/2 ins. diam. iron rod with 1 ins. yellow plastic cap mkd. Edwards LS 951, flush with ground, bears N. 42 1/2° W., 43.3 ft. dist.

and accessory mkd. by Primm:

- A 5/8 ins. diam. iron rod, no cap, down 2 ins. below gravel, bears S. 76° W., 61.3 ft. dist.

Description of monument and accessories I established to perpetuate original location of this corner:


NAD '83 autonomous C/A code geographic position:

Lat. 45°47'03.1" N
Long. 119°12'18.1" W

I hereby certify that the corner was monumented and accessories taken as described, using a staff compass, set with 15 1/2° East declination, and steel tape on November 15, 2013.

Witnesses: Kristina Powell

Office of _____ County Surveyor _____ County of _____ Umatilla
 State of _____ Oregon _____, I hereby certify that the within instrument was filed in this office
 for record on the 18th day of December, 20 13
Dave Krumbein by Gary Roberts
 (COUNTY OFFICIAL) (DEPUTY)

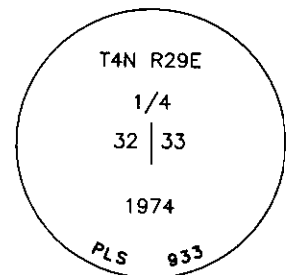

REGISTERED
PROFESSIONAL
LAND SURVEYOR

[Signature]
OREGON
JANUARY 18, 1994
RON C. WALTER
2648

Renewal Date: June 30, 2014