

OREGON CORNER RESTORATION FORM

COUNTY: Umatilla DATE: 07/10/13

CORNER DESIGNATION: 3N32, A11, The North One-Quarter Corner of Section 4.

PREVIOUS RENEWALS/SURVEYS ETC.: Corner originally established by David Thompson, under GLO Contract 106, dated August 1864, notes state: Set post for 1/4 Sec. corner in mound of Earth with charred stake, pits, trench &c as per instructions.

MONUMENT AND ACCESSORIES FOUND: None.

MONUMENT MARKING DETAIL:

T4N R32E
1 S33
4 S4
T3N
2013
PLS 54657

MONUMENT SET: At intersection of centerline of South Cold Springs Road and field berms North and South, set a 5/8" x 24" iron rod with a 2" aluminum cap, 1 inch below asphalt road surface, stamped as stated in "Monument Marking Detail", from which:

A 5/8" x 24" iron rod with a 1 1/4" purple plastic cap stamped "Wells Surveying, PLS 54657" bears North 54° East, 50.6 feet.

A 5/8" x 24" iron rod with a 1 1/4" purple plastic cap stamped "Wells Surveying, PLS 54647" bears South 53° East, 44.1 feet.

A 5/8" x 24" iron rod with a 1 1/4" purple plastic cap stamped "Wells Surveying, PLS 54647" bears South 45° West, 31.4 feet.

A 5/8" x 24" iron rod with a 1 1/4" purple plastic cap stamped "Wells Surveying, PLS 54647" bears North 05° East, 17.8 feet.

Attached bearing object signs to all accessories.

LOCATION AND COMMENTS: At point in centerline of South Cold Springs Road with field berms North and South.


OREGON STATE PLANE COORDINATE, North Zone, NAD 83(91), International Feet:
N= 773482.33'
E= 8631256.12'

FIRM: Wells Surveying
P.O. Box 1696
Pendleton, OR 97801

COMPASS DECLINATION: 18° East

Surveyor's Seal

Witnesses: Jason Wells, PLS
Dean Roy
3N32A11

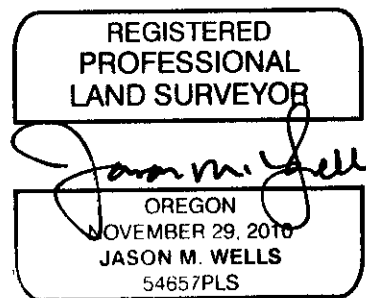

RENEWS: 6-30-14