


CERTIFIED RECORD OF LAND CORNER MONUMENTATION

HISTORY OF ORIGINAL CORNER ESTABLISHMENT:

Originally established by George S. Pershin, U.S. Deputy Surveyor, under Contract No. 332, dated July 29, 1879. Surveyor record states:

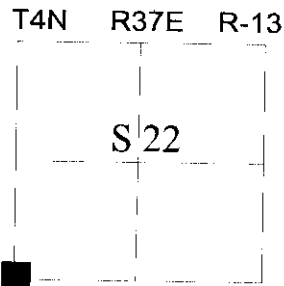

Set Fir post on North descent for corner to secs. 21, 22, 27 and 28, from which:

- A fir, 8 ins. dia. bears N34°E, 28 lks. dist.
- A tamarack, 22 ins. diam. bears S14°E, 63 lks. dist.
- A fir, 6 ins. dia. bears N34°E, 28 lks. dist.
- A fir, 15 ins. diam. bears N28°W, 22 lks. dist.

On monumentation record Q-724, Douglas Ferguson finds a rotted tamarack stump from which he sets a 5/8" iron pin with plastic cap marked LS645, from which:
 A spruce 8" dia. bears N66E, 38.67 ft., scribed T4N R37E S22 BT.
 A white fir 9" dia. bears S58°30'E, 52.37 ft., scribed T4N R38E S27 BT.
 A spruce 9" dia. bears S72°30'W, 59.70 ft., scribed T4N R37E S28 BT.
 A spruce 13" dia. bears N43°30'W, 87.46 ft., scribed T4N R37E S21 BT.

In survey number 93-64-C, William Wells finds a 1" iron pipe with a 2" brass cap and a 5/8" rebar with a plastic cap marked LS 645 in a mound of stone, from which:
 A 10" spruce (pushed over) bears N69°E, 39.1 ft. marked T4N R37E S22 BT.
 A 15" spruce with visible scribing in a mostly closed blaze bears S53°E, 53.0 feet.
 A 14" spruce stump with the bottom of a blaze bears N48°W, 88.0 feet.

- And takes new accessories:
- A 11" fir brs. S89°W, 29.0 ft. marked T4N R37E S28 BT.
 - A 10" fir brs. N54°W, 84.6 ft. marked T4N R37E S21 BT.
 - A 27" fir brs. N28°E, 67.6 ft. marked T4N R37E S22 BT.

DESCRIPTION OF CORNER EVIDENCE FOUND:

Found a 1" iron pipe, 3" above ground, in a collar of stone, with a 2" brass cap marked as shown below, from which:

- A fir stump bears North 34° East, a distance of 67.60 feet, with visible scribe marks on an open blaze.
- A 20 inch White Fir bears South 55° East, a distance of 53.00 feet, alive and vigorous with a healed blaze.
- A dead and downed fir, the root hole of which bears approximately South 89° West, a distance of 29 feet.
- A 20 inch White Fir bears North 49° West, a distance of 84.6 feet, alive and vigorous with healed blaze.

DESCRIPTION OF MONUMENT AND ACCESSORIES I ESTABLISHED

TO PERPETUATE THE ORIGINAL LOCATION OF THIS CORNER:

NEW BEARING TREES:


- A 15 inch Spruce bears North 74° East, a distance of 73.70 feet, marked T4N R37E S22 BT.
- A 5 inch White Fir bears South 57° West, a distance of 27.75 feet, marked X BT.

I hereby certify that the corner was perpetuated on October 23, 2013.

**REGISTERED
PROFESSIONAL
LAND SURVEYOR**

OREGON
June 2, 2010
JEFFERY S. HSU
83571

Renewal Date: June 30, 2015

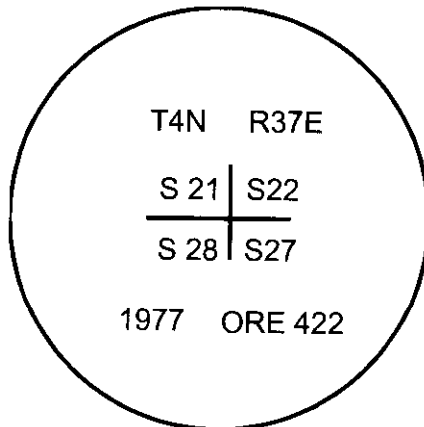

RECEIVED BY
 Umatilla County Surveyor
 Date: 11/6/2013
 Rec'd By: Jerry Takert
 No.: 13-533-B

I used a steel tape and magnetic compass in the establishment of the new accessories. I use 16° East declination. The distance to the new bearing trees are to a 60d spike driven into the right side of the root crown of the bearing trees.