

Form 874-9

U. S. DEPARTMENT OF AGRICULTURE
FOREST SERVICE



Umatilla NATIONAL FOREST

CORNERS OF THE PUBLIC SURVEY

T. 3-4 N. R. 37 E. W. Mer.

Section Corner common to Sections
33 34 3 and 4

DESCRIPTION OF CORNER

Corner consists of a stake, good condition

Dimension above ground 5 inches.

Sketch grooves, letters, figures, or notches, on proper face or edge.

CARDINAL POSITION

DIAGONAL POSITION

N W S E

NW SW SE NE

Mound of ----- is located -----

Pits are located -----

Sketch markings of Bearing Trees (or Rocks) in proper box and fill blanks below, giving bearings from Corner to Trees and Distances in Links.

T 3N
R 37
S. 3

T 3N
R 37
S. 4

T 4N
R 37
S. 33

BT

BT

BT

Species W.F. W.F. W.F.

Diameter 10" 12" 14"

Bearing S55E S14E N.55W.

Distance 1/6 C. 1/7C. 1/10ch.

Do you believe this to be a genuine Land Office Corner? **Yes.**

If not, why? -----

Albert Baker

Signature.

9-19-27

Date.


Forest Ranger

Title.

T. 3-4 N. R. 37 E. W. Mer.

8-3027

(Make sketch of topography near Corner.)

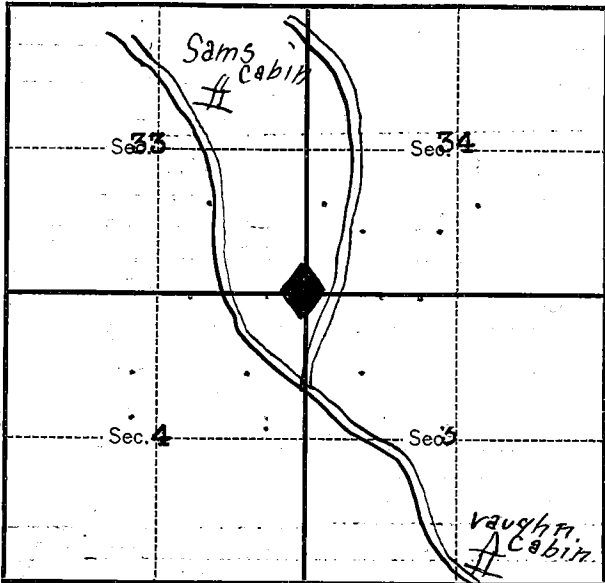

Metal Location Poster is on a -----
tree ----- inches diameter, on the -----
side of -----
from which this Corner bears -----
----- chains distant.

Give any further facts which will aid in finding this
Corner again.


Witness tree for Sec. 3 is dead.

**Corner is in forks of road leading
to the Vaughn cabin**

LAND CORNER RECORD

1. T 3N R 37E No. A 13 Cor. Sec Mer. Will State Oregon N. F. Umatilla Dist. Pendleton **3**

2. Corner Status

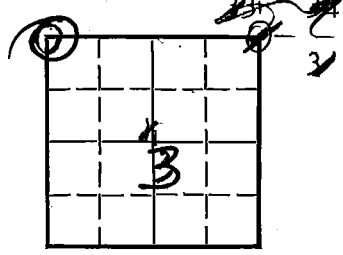

3. Original Description Resurvey Vol. 180 Page 15 Where Recorded GLO year 1879

4. Description of Corners: Resurvey set fir post on level for corner to sections 3, 4, 33, & 34.

See Mon. ? file.

- Tamarack 12" di. brs. N 34° E 54 lks. dist
- Tamarack 11" di. brs. S 46° E 20 lks. dist.
- Fir 18" di. brs. S 52° W 43 lks. dist.
- Tamarack 14" di. brs. N 62° W 31 lks. dist.

5. Investigation Notes: Found 8" L.P. with N.F.B. sign tag on south face. scribing on sign by L.D. Bailey 8-30-57, has 5' 8, sec. cor 3 & 4 in upper left hand corner.

Area has been logged. No B.Ts. Unable to locate sec. cor. referred to by Bailey on tag.

If Bailey's notes could be found many corners might be located. He has initialed quite a few signs on this district.



7. Photo Identification
Photo No. UM 32B-5
Ident. By: _____

8. Plane Coordinate Position Data
State _____ Zone _____
X _____
Y _____
Estab. By _____
Field Book No. _____
Where Filed _____

9. Evaluation
Authentic _____
Needs Verif. X Monument NO
Re-estab. _____ Survey _____
Land Status _____

6. Signed A. Galbraith Title Range Tech. Date 5-14-64

Handwritten signature or mark.

PERPETUATION RECORD

10. Monument:

11. Accessories

Field Book _____ Page _____

12. Set By _____ Title _____

License # _____ Agency _____ Date _____

13. Recorded By _____ Volume _____ Page _____
(Agency)

(Date) (City) (County) (State)

14. Remarks:

A-13

USDA-FOREST SERVICE

Index File No. 2-13

CORNER RECORD (SEARCH)
(Ref. FSM 7151.4)

Tract or Survey No. C

Cor. No. 2-13


T 4 N R. 37 E

R.D. _____ County _____

Merid. _____

N.F. _____ State _____

CORNER DIAGRAM

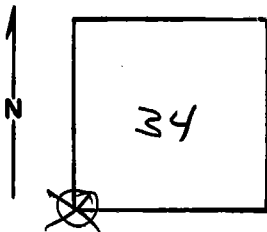

DESCRIBE CORNER MONUMENT FOUND

found 24" x 10" x 4" stone, 14" in ground. (No record of it,) It fit fergusons survey and he accepted it to continue his retracement survey. (See Monumentation file) 10-78

DESCRIBE BEARING TREES OR OTHER OFFICIAL ACCESSORIES FOUND

None found.
No new B.I.T.'s set.

PHOTO IDENTIFICATION DATA

Photo No. _____
Filed At. _____
Object Ident. _____
Ident. By _____

Signature _____

PLANE COORDINATE POSITION DATA

State _____ Zone _____
X _____
Y _____
Estab. By _____

Agency _____

Signature

TGH

Title

Division

Headquarters

Date

2-9-79

7100-52-(3/68)

5

CORNER RECORD (PERPETUATION)

MONUMENT : DESCRIBE NEW MONUMENT SET, OR WORK DONE TO PRESERVE EXISTING MONUMENT

ACCESSORIES : DESCRIBE NEW BT's WITNESS OBJECTS ETC. ESTABLISHED, OR WORK DONE TO PRESERVE EXISTING EVIDENCE

Work Done By _____ Title _____ Date _____ State Registration No. or Agency _____

Certified Cor. Record Prepared ? Yes No Filed At: _____ Date _____

REMARKS

Index File No. T. R. M. Tract or Surv. No. Cor. _____