


Index
File No. U-23

CORNER RECORD (SEARCH)

(Ref. FSM 7151.4)

Tract or
Survey No. _____ Cor.
No. _____T 4S R. 30ER.D. Ukiah County UmatillaMerid. WillametteN.F. Umatilla State Oregon

CORNER DIAGRAM

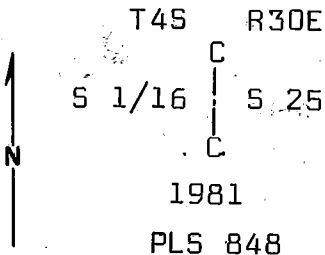

DESCRIBE CORNER MONUMENT FOUND

Corner not previously established.

DESCRIBE BEARING TREES OR OTHER OFFICIAL ACCESSORIES FOUND

N/A

PHOTO IDENTIFICATION DATA

Photo No. _____

Filed At. _____

Object Ident. _____

Ident. By _____

Signature

PLANE COORDINATE POSITION DATA

State _____ Zone _____

X _____

Y _____

Estab. By _____

*Agency**Signature*Title
PLS 848

Division

Headquarters
Mt. Vernon, ORDate
7/30/81. 7100-52-(3.68)

6

7

8

9

10

11

12

13

DESCRIBE CORNER LOCATION RELATIVE TO NEAR-BY FEATURES, ALSO HOW TO REACH CORNER

Corner on a N.E. slope in open timber.
N-S fence line approx. 15 ft. east.

4

5

6

7

8

9

10

11

CORNER RECORD (PERPETUATION)

MONUMENT: DESCRIBE NEW MONUMENT SET, OR WORK DONE TO PRESERVE EXISTING MONUMENT

Set 3"x30" galv. iron pipe with 3" brass cap stamped as shown on the diagram. Set pipe 26 inches in the ground.

From which:

ACCESSORIES : DESCRIBE NEW BT'S WITNESS OBJECTS ETC. ESTABLISHED, OR WORK DONE TO PRESERVE EXISTING EVIDENCE

A pine 12 inches dia. bears N51°W, 53.8 ft. scribed CS 1/16 S 25 BT.
A pine 13 inches dia. bears S88°E, 7.7 ft. scribed CS 1/16 S 25 BT.
Set steel posts with warning and boundary signs 5 ft. South and 5 ft. West from corner.
Nailed bearing tree signs and brass washers stamped PLS 848 to each tree.
Painted red band around each tree.

Work Done By D.M. Ferguson Title Surveyor Date 7/30/81 State Registration No. OR PLS 848
or Agency

Certified Correct as Prepared? Yes No Filed At: Umatilla Co. Surveyor Off. Date

REGISTERED
PROFESSIONAL
LAND SURVEYOR

REMARKS

Douglas M. Ferguson
OREGON
JULY 12, 1968
DOUGLAS M. FERGUSON
848

Witnesses to above corner:
D. Mitchell Ferguson
Mike Woodward