

Index File No. 2-9


CORNER RECORD (SEARCH)

Tract or Survey No. \_\_\_\_\_ Cor. No. 2-9 <sup>26</sup> **3**

T 4S R. 30E Merid. Willamette

R.D. Ukiah County Umatilla N.F. Umatilla State Oregon

CORNER DIAGRAM

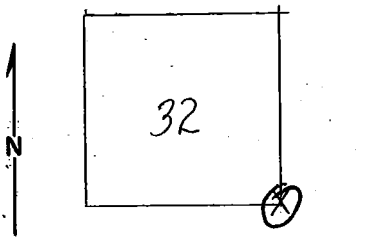

~~DESCRIBE CORNER MONUMENT FOUND~~ *Original notes*  
a pile of rocks which the N-W BT fell across  
BT dead PP S59W, 67 lks (scribing clear)  
PP 24" DBH, S72E, 149 lks (scribing needs to be cut out)  
PP 20" " N68E, 180 lks ( " " " " " " )

DESCRIBE BEARING TREES OR OTHER OFFICIAL ACCESSORIES FOUND

All BTs have form 448

PHOTO IDENTIFICATION DATA

Photo No. \_\_\_\_\_  
Filed At. \_\_\_\_\_  
Object Ident. \_\_\_\_\_  
Ident. By \_\_\_\_\_  
*Signature*

DESCRIBE CORNER LOCATION RELATIVE TO NEAR-BY FEATURES, ALSO HOW TO REACH CORNER

Sec. Line Board on Road S-518, thus south to sec. cor. (in small opening)

PLANE COORDINATE POSITION DATA

State \_\_\_\_\_ Zone \_\_\_\_\_  
X \_\_\_\_\_  
Y \_\_\_\_\_  
Estab. By \_\_\_\_\_  
*Agency*

Signature: 151 Walton A. Young Title: Forest Tech. Division: \_\_\_\_\_ Headquarters: \_\_\_\_\_ Date: 4-8-65 7100-52 REV. 65 5

CORNER RECORD (PERPETUATION)

MONUMENT: DESCRIBE NEW MONUMENT SET, OR WORK DONE TO PRESERVE EXISTING MONUMENT

9

ACCESSORIES : DESCRIBE NEW BT'S WITNESS OBJECTS ETC. ESTABLISHED, OR WORK DONE TO PRESERVE EXISTING EVIDENCE

10

Work Done By \_\_\_\_\_ Title \_\_\_\_\_ Date \_\_\_\_\_ State Registration No. or Agency \_\_\_\_\_

Certified Cor. Record Prepared ? Yes No Filed At: \_\_\_\_\_ Date \_\_\_\_\_

11

REMARKS

12

Index File No. Z-9 T. R. M. Tract or Surv. No. Cor. 13