


(PA)

Index  
File No. 7-7CORNER RECORD (SEARCH)  
(Ref. FSM 7151.4)Tract or  
Survey No. \_\_\_\_\_ Cor.  
No. 7-7T 3S R. 32E R.D. Ukiah County UmatillaMerid. Willamette N.F. Umatilla State Oregon

## CORNER DIAGRAM

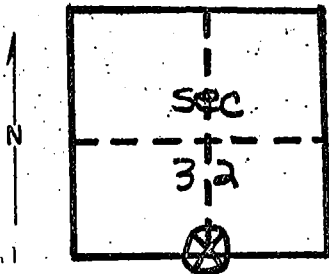

## DESCRIBE CORNER MONUMENT FOUND

No Corner was found.

## DESCRIBE BEARING TREES OR OTHER OFFICIAL ACCESSORIES FOUND

16" Ponderosa Pine good vigor.  
22" Ponderosa Pine

## PHOTO IDENTIFICATION DATA

Photo No. \_\_\_\_\_  
Filed At. \_\_\_\_\_  
Object Ident. \_\_\_\_\_  
Ident. By \_\_\_\_\_  
*Signature*

## PLANE COORDINATE POSITION DATA

State \_\_\_\_\_ Zone \_\_\_\_\_  
X \_\_\_\_\_  
Y \_\_\_\_\_  
Estab. By \_\_\_\_\_  
*Agency*

## DESCRIBE CORNER LOCATION RELATIVE TO NEAR-BY FEATURES, ALSO HOW TO REACH CORNER

Signature D. McCullough Title FOR. Tech. Division USFS Headquarters Ukiah Date 10/3/68 7100-52-(3/68)