


CERTIFIED RECORD OF LAND CORNER MONUMENTATION

History of original corner establishment:

None

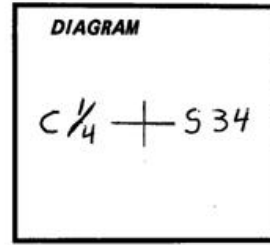

x-15

Description of corner evidence found:

None

Description of monument and accessories established to perpetuate the original location of this corner:

Set a 2 1/2" Brass Cap on a 2 1/2" x 30" galvanized pipe set 24" in the ground mkd as shown:

From which:


A 8" Pine bears N 71° E, 29.65 ft. scribed C 1/4 S 34 BT
A 10" Pine bears N 52° W 113.4 ft. scribed C 1/4 S 34 BT

Blazes are painted red and trees have red bands painted around them, trees have signs numbers 54-3, 54-9 and brass washers stamped PLS 933 nailed to them.

Bearings were run with a staff compass set at a declination of 19° 30' E.
Distances were measured with a steel tape to the center of the tree.

This corner was set Oct. 2, 1983

By: Rod Punches
Witness: Brent Reynolds

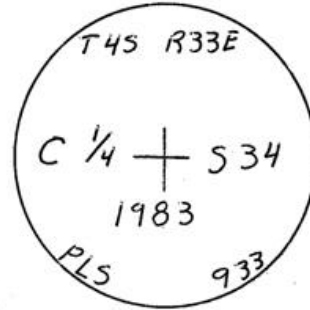

REGISTERED
PROFESSIONAL
LAND SURVEYOR

David H. Krumbain

OREGON
JULY 17, 1970
DAVID H. KRUMBEIN
933

Office of..... County Surveyor..... County of..... Umatilla
State of..... Oregon....., I hereby certify that the within instrument was filed in this office
for record on the..... day of....., 19.....
..... by
(COUNTY OFFICIAL) (DEPUTY)