

CERTIFIED RECORD OF LAND CORNER MONUMENTATION


History of original corner establishment:

Corner established by George S. Pershin under GLO Contract No. 410 in Sept. 1881.

Set a basalt stone 20" x 20" x 8", 15" in ground mkd $\frac{1}{4}$ " on West face from which a:

Pine 14" dia. bears N 60° E, 70 links mkd $\frac{1}{4}$ S BT

Raised mound of stone along side

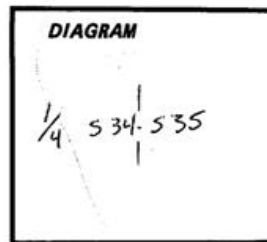

Description of corner evidence found:

Numerous stones but none with visible markings.

Possible BT stump well rotted.

Corner was set off the possible BT stump as this matches Pershin's call to the fresh water spring at 48.5 ch North of the Section Corner.

Description of monument and accessories I established to perpetuate the original location of this corner:

Set a 2 1/2" dia. Brass Cap on 2 1/2" x 30" galvanized pipe set 6" in ground. Built stone mound around cap 4' dia. mkd as shown:

From Which:


A 8" Pond Pine bears N 09° E 45.8 feet scribed $\frac{1}{4}$ S 35 BT
A 12" Pond Pine bears S 73° 30' W 22.0 feet scribed $\frac{1}{4}$ S 34 BT

Blazes are painted red, trees have red bands painted around them and have signs #54-3 and 54-4 and have Brass Washers stamped PLS 933 nailed to them.

This corner was set Oct. 2, 1983

By: Rod Punches

Witness: Brent Reynolds

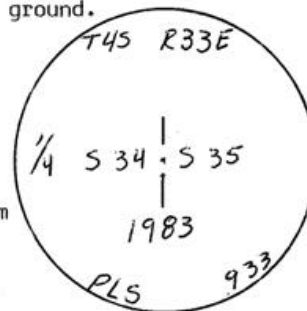

Office of... County Surveyor County of... Umatilla
Oregon
State of... Oregon, I hereby certify that the within instrument was filed in this office
for record on the 26 day of November 1984
..... by Betty Cochran
(COUNTY OFFICIAL) (DEPUTY)