

Index

File No. X-19

CORNER RECORD (SEARCH)

(Ref. FSM-7151.4)

Tract or

Survey No. _____

Cor.

No. C 1/4

T 45 R. 33E

R.D. Ukiah

County Umatilla


Merid. Willamette

N.F. Umatilla

State Oregon

CORNER DIAGRAM

T45 R33E

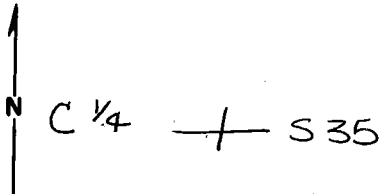

DESCRIBE CORNER MONUMENT FOUND

NONE

DESCRIBE BEARING TREES OR OTHER OFFICIAL ACCESSORIES FOUND

NONE

PHOTO IDENTIFICATION DATA

Photo No. _____

Filed At. _____

Object Ident. _____

Ident. By _____

Signature

PLANE COORDINATE POSITION DATA

State _____ Zone _____

X _____

Y _____

Estab. By _____

Agency

DESCRIBE CORNER LOCATION RELATIVE TO NEAR-BY FEATURES, ALSO HOW TO REACH CORNER

From Junction of Ukiah-Hilgard Highway and Forest Road 54 Go East 1.3 mi., Park and walk uphill 850 feet to S 1/4 C-C S 35 then 1320 feet up Ravine to corner

Signature

David H. Klein

Title

PLS 933

Division

Headquarters

Date

7-1983

7100-52 (3. 68)

CORNER RECORD (PERPETUATION)

MONUMENT: DESCRIBE NEW MONUMENT SET, OR WORK DONE TO PRESERVE EXISTING MONUMENT

Set a 2 1/2" Brass Cap on a 2 1/2" x 30" Galvanized Pipe Set 24" in the Ground Marked:

T45 R33E
C 1/4 + S 35
1983
PLS 933

ACCESSORIES: DESCRIBE NEW BT'S WITNESS OBJECTS ETC. ESTABLISHED, OR WORK DONE TO PRESERVE EXISTING EVIDENCE

A 36" Ponderosa Pine bears S 47° 45' E 18.3 Feet Scribed C 1/4 S 35
A 9" Ponderosa Pine bears S 50° W 25.9 Feet scribed C 1/4 S 35
Blazes are Painted Red and have Red bands Painted around them.
Trees have Signs Numbers 54-3, 54-9 and Brass Washers Stamped PLS 933
nailed to them.

Work Done By: D. Krumboltz Title Surveyor Date 7/83 State Registration No. or Agency PLS 933

Certified Cor. Record Prepared? Yes No Filed At: Umatilla County Date 7-1983

REMARKS

9
10
11
12
13