

Index  
File No. X-9


CORNER RECORD (SEARCH)

(Ref. FSM 7151.4)

Tract or Survey No. \_\_\_\_\_  
Umatilla  
Cor. X-9  
No. \_\_\_\_\_

T 45 R. 33E R.D. Ukiah County \_\_\_\_\_  
Merid. \_\_\_\_\_ N.F. Umatilla State Oregon

CORNER DIAGRAM

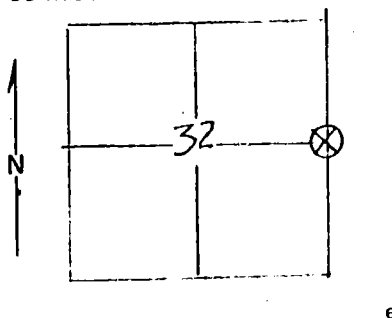

DESCRIBE CORNER MONUMENT FOUND

A stone 15"x10"x8" was found in poor condition all above ground.  
No markings could be found.

2

DESCRIBE BEARING TREES OR OTHER OFFICIAL ACCESSORIES FOUND

There is an old logging road east of this corner about 600'.  
There is a 28" pine young and in good vigor with scribing clearly visible 1/45 - this has been chopped out. A pine snag 36" DBH has been fallen in a recent logging operation but was not taken because it was unmerchantable. It has K, S, and Bt plainly visible on it. These two trees have a 6" red band painted around them and Bt tags attached to front facing corner with an attention

3

PHOTO IDENTIFICATION DATA

Photo No. \_\_\_\_\_  
Filed At. \_\_\_\_\_  
Object Ident. \_\_\_\_\_  
Ident. By \_\_\_\_\_  
*Signature*

7

PLANE COORDINATE POSITION DATA

State \_\_\_\_\_ Zone \_\_\_\_\_  
X \_\_\_\_\_  
Y \_\_\_\_\_  
Estab. By \_\_\_\_\_  
*Agency*

8

DESCRIBE CORNER LOCATION RELATIVE TO NEAR-BY FEATURES, ALSO HOW TO REACH CORNER

4

*Signature*  
MLC

*Title*  
For, Tech,

*Division*  
USFS

*Headquarters*  
Ukiah

*Date*  
5/16/77

7100-52 (3/68)

5