

USDA-FOREST SERVICE

Index
File No. A-25

CORNER RECORD (SEARCH)

(Ref. FSM 7151.4)

Tract or Survey No. Sec 1 Cor. No. NE Cor


T 5S R. 32E

R.D. Ukiah County Umatilla

Merid. Willamette

N.F. Umatilla State Oregon

CORNER DIAGRAM

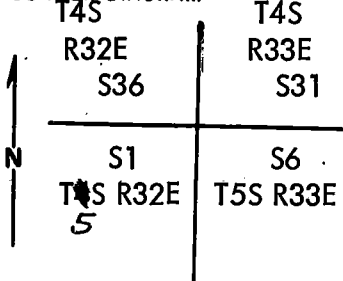

DESCRIBE CORNER MONUMENT FOUND

none

DESCRIBE BEARING TREES OR OTHER OFFICIAL ACCESSORIES FOUND

none

PHOTO IDENTIFICATION DATA

Photo No. _____

Filed At. _____

Object Ident. _____

Ident. By _____

Signature

PLANE COORDINATE POSITION DATA

State _____ Zone _____

X _____

Y _____

Estab. By _____

Agency

DESCRIBE CORNER LOCATION RELATIVE TO NEAR-BY FEATURES, ALSO HOW TO REACH CORNER

Cross Camas Creek at the R32E T4S R33E and drive up old road .8 miles

to $\frac{1}{4}$ $\frac{31}{6}$ proceed westerly along road, staying on top of ridge .6 miles to corner.

Signature

William R. Wells

Title

PLS 1106

Division

Headquarters

Date


7-26-79

7100-52-(3/68)

CORNER RECORD (PERPETUATION)

MONUMENT: DESCRIBE NEW MONUMENT SET, OR WORK DONE TO PRESERVE EXISTING MONUMENT

Set 2"x30" galvanized iron pipe 10" in ground
with a mound of stone around it, marked:

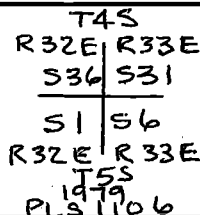

Set steel fence post north and east of corner and attached 54-2 to both posts and 54-4 to one post.

ACCESSORIES: DESCRIBE NEW, BT'S WITNESS OBJECTS ETC. ESTABLISHED, OR WORK DONE TO PRESERVE EXISTING EVIDENCE

Set 4 2"x30" iron pipe reference monuments with brass caps:

- (1) A R.M. bears N 77° W 29.89 ft to center marked: (1) T4SR32E (2) T4SR33E (3) T5SR33E (4) T5SR32E
- (2) A R.M. bears N 17½° E 21.81 ft to center marked: (2) T4SR33E (3) T5SR33E (4) T5SR32E
- (3) A R.M. bears S 39° E 14.94 ft to center marked: 1979 PLS1106
- (4) A R.M. bears S 64° W 35.59 ft to center marked: PLS1106

Reference monuments are set 10" in ground with mounds of stone around each monument.

Work Done By William R. Wells Title PLS Date 7-26-79 State Registration No. 1106
or Agency

Certified Cor. Record Prepared? Yes No Filed At Umatilla County Surveyor's Office Date

Witnesses: Greg Flowers, L.S.I.T
Brent Reynolds

REMARKS

The ground is rocky and hard bed rock is 9"-10" below surface.

Index File No. A-25 T. 55

R. 32E

M. Willetta

Tract or Surv. No. Sec 1

Cor. NE corner
U.S. G.P.O. 1977-725-576/586