

USDA-FOREST SERVICE

Index

File No. R-5

CORNER RECORD (SEARCH)

(Ref. FSM 7151.4)

Tract or Survey No. _____

Cor. No. _____

T 4S R. 34E

R.D. LaGrande


County Union

Merid. Willamette

N.F. w-w

State Oregon

CORNER DIAGRAM

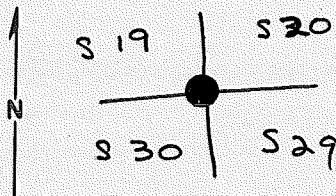

DESCRIBE CORNER MONUMENT FOUND

DESCRIBE BEARING TREES OR OTHER OFFICIAL ACCESSORIES FOUND

A root hole, brs N29E, 208 lbs, w/down + decayed pine along scribe marks T4S R34E visible on open blaze.

Pine snag, 38" dia, brs S52W, 144 lbs, w/ scribe marks S30 visible on open blaze.

Pine snag, 34" dia, brs N61W, 325 lbs, w/ scribe marks 4S visible on open blaze.

DESCRIBE CORNER LOCATION RELATIVE TO NEAR-BY FEATURES, ALSO HOW TO REACH

PHOTO IDENTIFICATION DATA

Photo No. _____

Filed At. _____

Object Ident. _____

Ident. By _____

Signature

7

PLANE COORDINATE POSITION DATA

State _____ Zone _____

X _____

Y _____

Estab. By _____

Agency

8

Signature

Title

Division

Headquarters

Date

7100-5

CORNER RECORD (PERPETUATION)

MONUMENT: DESCRIBE NEW MONUMENT SET, OR WORK DONE TO PRESERVE EXISTING MONUMENT

Set Brass Caps mkd: T4S R34E
 S19 | S20
 S30 | S29
 1977

ACCESSORIES: DESCRIBE NEW BT'S WITNESS OBJECTS ETC. ESTABLISHED, OR WORK DONE TO PRESERVE EXISTING EVIDENCE

Lodgepole pine, 9" dia, bears N34E, 27 lks mtd T4S R34E S20 BT.
 Grand fir, 8" dia, brs S27E, 106 lks dist, mkd. T4S R34E S29 BT.
 " " 7" " " S24W, 47 lks " " T4S R34E S30 BT.
 Lodgepole pine, 12" dia, brs N66'SW, 31 1/2 lks dist, mtd T4S R34E S19 BT.

Set a 5/4. steel fence post alongside iron post.

Work Done By BLM Title _____ Date 9/77 State Registration No. _____
 or Agency _____

Certified Cor. Record Prepared? Yes No Filed At: _____ Date _____

REMARKS

USDA-FOREST SERVICE

Index File No. R-5

CORNER RECORD (SEARCH)

(Ref. FSM 7151.4)

Tract or Survey No. _____ Cor. No. R-5


T 4 S R. 34 E

R.D. Umatilla County Umatilla

Merid. Will.

N.F. Umatilla State Oregon

CORNER DIAGRAM

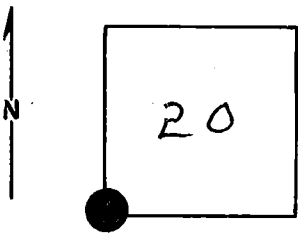

DESCRIBE CORNER MONUMENT ~~FOUND~~ SET

Brass Cap; 1977

DESCRIBE BEARING TREES OR OTHER OFFICIAL ACCESSORIES FOUND 2

Notes on file; see Monumentation File

PHOTO IDENTIFICATION DATA

Photo No. _____

Filed At. _____

Object Ident. _____

Ident. By _____

Signature 7

PLANE COORDINATE POSITION DATA

State _____ Zone _____

X _____

Y _____

Estab. By _____

Agency 8

DESCRIBE CORNER LOCATION RELATIVE TO NEAR-BY FEATURES, ALSO HOW TO REACH CORNER 3

Signature _____ Title _____ Division _____ Headquarters _____ Date _____ 4

7100-52-(3/68) 5

CORNER RECORD (PERPETUATION)

MONUMENT: DESCRIBE NEW MONUMENT SET, OR WORK DONE TO PRESERVE EXISTING MONUMENT

9

ACCESSORIES : DESCRIBE NEW BT'S WITNESS OBJECTS ETC. ESTABLISHED, OR WORK DONE TO PRESERVE EXISTING EVIDENCE

10

Work Done By _____ Title _____ Date _____ State Registration No. or Agency _____

11

Certified Cor. Record Prepared ? Yes No Filed At: _____ Date _____

REMARKS

12

Index File No. T. R. M. Tract or Surv. No. Cor.

13