


CERTIFIED RECORD OF LAND CORNER MONUMENTATION

HISTORY OF ORIGINAL CORNER ESTABLISHMENT:

Survey records prior to 1976 not reviewed.

Umatilla County Survey No. L-79-C: "Fd. Stone with + in top and 3/4" pipe alongside",
Umatilla County Survey No. 083-201-B: "Reconstructed from CS # L-79",
Umatilla County Survey No. 00-064-B: "Computed Location from Griffis 1983 Survey"

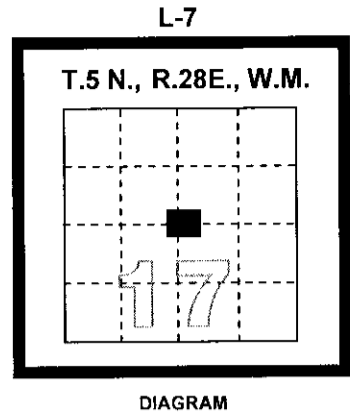


DESCRIPTION OF CORNER EVIDENCE FOUND:

February 15, 2013: Found stone, buried 1.5 feet, with visible "X" on top. Found 3/4" diameter Iron Pipe along North side of stone.

Found stone and 3/4" iron pipe are located approximately 7 feet Northwesterly of "Second Base" at the Umatilla School District No. 6 baseball field.

DESCRIPTION OF MONUMENT AND ACCESSORIES I ESTABLISHED TO PERPETUATE THE ORIGINAL LOCATION OF THIS CORNER:

No restorative work performed.

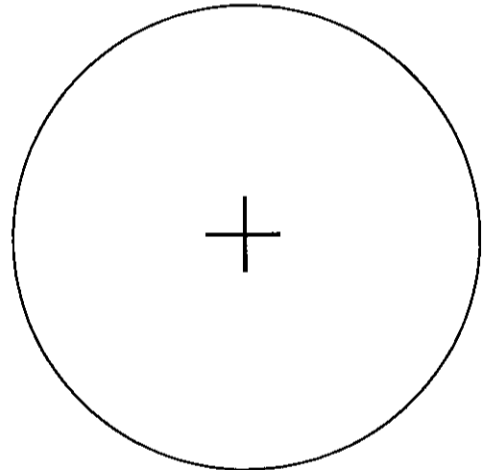

SPCS OREGON NORTH (International Feet)

NAD83 (91)
Northing: 821944.62
Easting: 8497696.76

I hereby certify that the above survey monument was found as hereon described on February 15, 2013.

Witness: Ryan Hays, Survey Technician
Anderson Perry & Assoc., Inc.
1901 N. Fir Street
La Grande, Oregon 97850
(541)963-8309

RECEIVED BY
Umatilla County Surveyor
Date: 3/28/2013
Rec'd By: [Signature]
No.: 13-133-R

REGISTERED
PROFESSIONAL
LAND SURVEYOR

OREGON
JANUARY 20, 1998
MICHAEL E. ROSADA
0264865

EXPIRES: 12-31-14

DATED: 03-14-2013