

OREGON CORNER RESTORATION FORM

SECTION 19 TOWNSHIP 5N RANGE 28E

N-1

COUNTY: UMATILLA DATE 1/90

CORNER DESIGNATION

NW Corner

CONDITION REPORT ONLY

- NOT FOUND
- RENEWED
- UNRECORDED
- SURVEYED IN
- REFERENCED OUT



PREVIOUS RENEWALS/SURVEYS, ETC.

Original survey by Davenport in 1861 under Contract #101. A Dependent Resurvey was performed by the BLM, this 1975 BLM survey accepted Staebler's Brass Cap.

MONUMENTS & ACCESSORIES FOUND: Condition and Source

Found a 2 1/2" Brass Cap on an Iron Pipe. This cap was set in 1972 by Don Staebler. It lies N 89° 53' 41" W 12.48 feet from my single proportion location for this corner. The date stamped on cap was 1971. The BLM added 1974 to this cap.

MONUMENT DETAIL

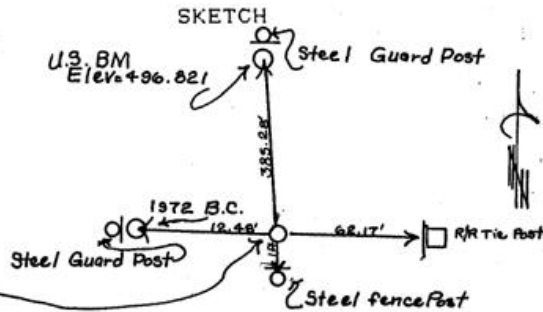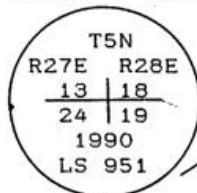

MONUMENT SET (PROCEDURES AND DESCRIPTION)

Set by single proportion a 1"x30" iron pipe with a Brass Cap, stamped as shown above, 0.4 feet above surface of ground and raised a soil mound around the Brass Cap. SEE MY 1989 AREA ONE COUNTY SURVEY.

NEW ACCESSORIES

- A steel Guard post with Bearing Object & Witness sign attached referencing B.M. Elev. 496.821 N 05° 22' 20" W 385.28 feet.
- A R/R tie with an Alum. tag #951 & Bearing Object sign attached S 89° 51' 10" E 62.17 feet. Dist. To Alum. Tag.
- A steel fence post w/ Bearing Object, Witness sign attached South 1 foot.
- A steel Guard post w/ Bearing Object & Witness sign attached referencing 1972 Brass Cap set by Staebler N 89° 53' 41" W 12.48 feet. Dist. To Brass Cap.

LOCATION & COMMENTS

From the NW corner of the new Umatilla City Cemetery, go West along a dirt track approx. 4400 feet to corner.

SURVEYOR'S SEAL

COMPASS DEC.
 FIRM EDWARDS SURVEYING
 P.O. BOX 763, HERMISTON,
 OREGON, 97838
 PARTY CHIEF D. EDWARDS
 NOTES
 WITNESS J. COPPOCK

REGISTERED
 PROFESSIONAL
 LAND SURVEYOR

G. Dennis Edwards

OREGON
 JULY 18, 1871
 G. DENNIS EDWARDS
 951

RECEIVED BY
 Umatilla County Surveyor
 Date 1-91
 Rec'd by KA
 No. 91-01-B