


C-23

History of original corner establishment:

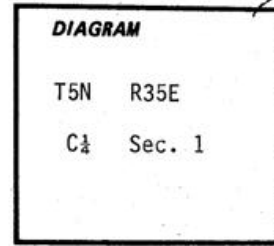


Description of corner evidence found:

None.

Description of monument and accessories I established to perpetuate the original location of this corner:

At the center of Sec. 1 as determined by survey, we set a 2"x30" galvanized iron pipe 28" in the ground, with brass cap attached, marked:

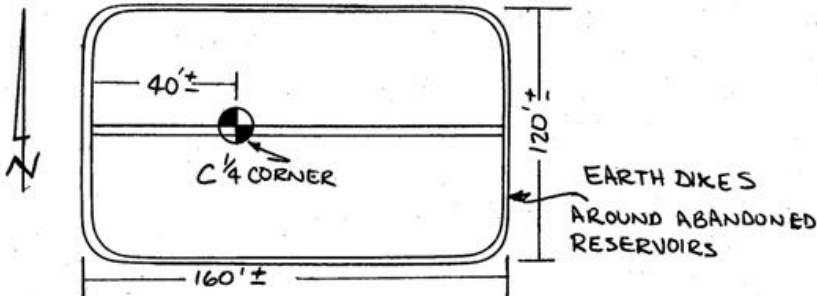

T5N R35E  
C $\frac{1}{4}$   
+  
Sec. 1  
1984  
OPLS 1099

Placed steel fence post with location poster alongside corner monument.

Witnesses: Gary L. Langlitz  
A. Ray Crapo

June 6, 1984



Office of Surveyor County of Umatilla  
 State of Oregon I hereby certify that the within instrument was filed in this office  
 for record on the 15th day of July 1984  
Dave Brunson by Betty Cochran  
 (COUNTY OFFICIAL) (DEPUTY)