

OREGON CORNER RESTORATION FORM

Section 19
County Umatilla

Township 5N
Date: 01/15/10

Range 35E

Corner Designation: 5N35N7

Corner common to section 17,20 T5NR35E

_____	Condition Report Only
___X___	Not Found
_____	Remonumented
_____	Unrecorded
___X___	Surveyed In
___X___	Referenced Out



Previous Renewals / Surveys, etc.

Surveyed by Wm. H. Odell & Wm. S. Lewis under Contract No. 110, dated February 7th 1865.

Monuments and Accessories Found: (Condition and Source)

None.

Diagram

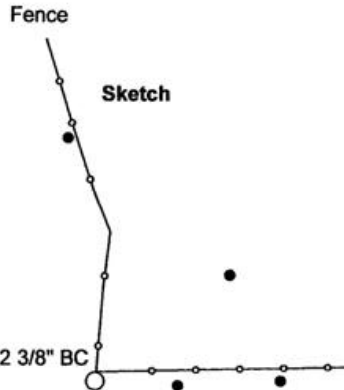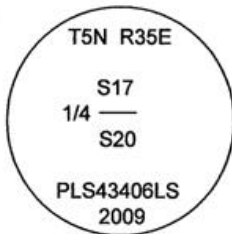

NAD 83/91
OREGON STATE PLANE NORTH
INTERNATIONAL FEET

N822285.91
E8720081.02
LAT - 45° 54' 15.046177" N
LON - 118° 27' 54.40325" W

Monument (s) Set (Procedures and Description)

Set a 1 1/2" Galvanized Iron pipe w/ a 2 1/2" Brass Cap Stamped as shown.
A 5/8" x 30" Iron Rebar w/ypc lies S 86° E, 14.71'.
A 5/8" x 30" Iron Rebar w/ypc lies S 86° E, 33.55'
A 5/8" x 30" Iron Rebar w/ypc lies N 30°30' E, 40.70'.
A 5/8" x 30" Iron Rebar w/ypc lies N 15°15' W, 47.66'.

References Set:

None

Location and Comments

South of a MET tower approximately
1/4 mile.

Compass Declination
17° E

Surveyors Seal

REGISTERED
PROFESSIONAL
LAND SURVEYOR

Robert Douglas English
OREGON
JANUARY 11, 2005
ROBERT DOUGLAS ENGLISH
43406LS

RENEWAL DATE: 12/31/11

RECEIVED BY:

Date: 12-07
Rec'd By: _____
No. 09-176-B

Firm / Agency

Survey One, LLC.
P.O. Box 382
Pendleton, OR 97801
(541) 276-2055