

OREGON CORNER RESTORATION FORM

Section 10 Township 5N Range 36E
 County Umatilla Date: May 22, 2012

Corner Designation: 5N36E15

Quarter corner common to sections 3 and 10,
 T5N, R36E, W.M., Umatilla County, Oregon.

Condition Report Only
 Not found
 x Remonumented
 Unrecorded
 x Surveyed in
 x Referenced out


Previous Renewals / Surveys, etc.

Corner originally set by Odell and Lewis under contract No. 110 dated February 7, 1865. Their record reads: Set 1/4 Sec. post on E. side of dry ravine.

Monument and Accessories found: (condition and source)


None. The point falls in a farmed field.

DIAGRAM

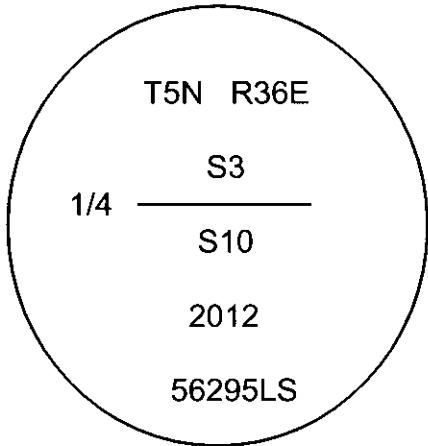

- ⊗ = Brass cap.
- = Rebar reference.
- = Power pole.
- x = guard post.

SKETCH

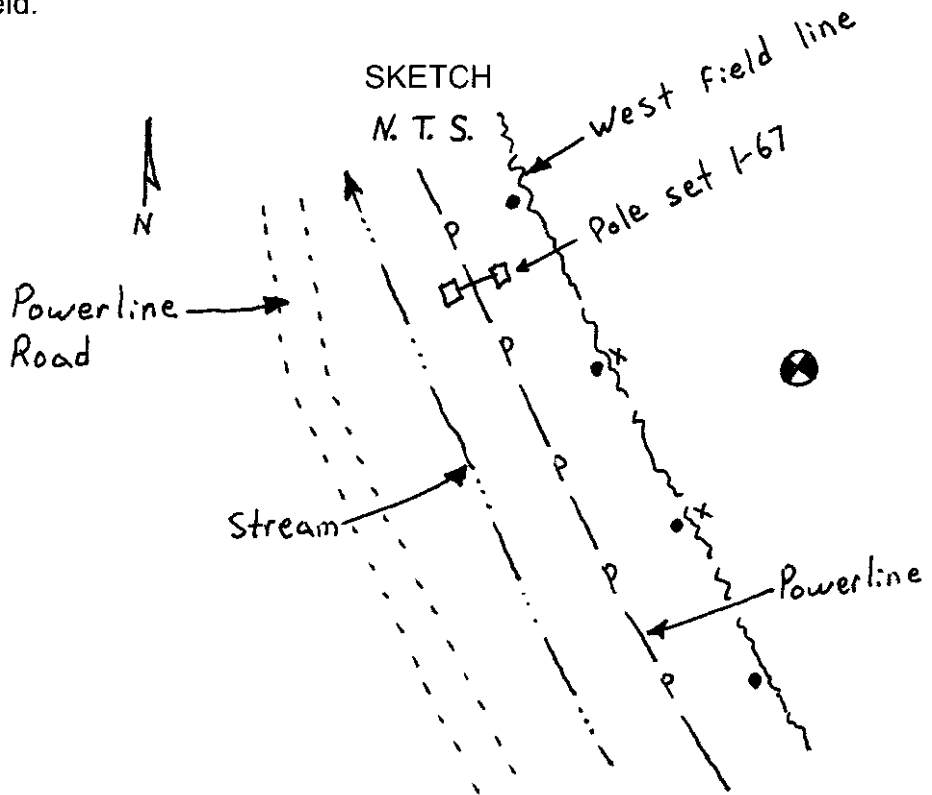

MONUMENT (S) AND ACCESSORIES SET (Procedures and Description)

At the proportioned point I set a 2 3/8" brass cap on a 1 1/2" x 30" galvanized iron pipe stamped stamped as shown in the diagram above 24" below the surface of the farmed field.

For references, I set four 5/8" by 24" iron rebars with 1 1/4" orange plastic caps stamped WTS and 56295LS as described below:

- an iron rebar bears S20°32'03"W, 97.53 feet at the toe of the berm on the W. edge of the field;
- an iron rebar bears S60°27'07"W, 79.69 feet at the toe of the berm on the W. edge of the field;
- an iron rebar bears N89°22'00"W, 94.57 feet at the toe of the berm on the W. edge of the field;
- an iron rebar bears N54°54'45"W, 193.63 feet at the to of the berm on the W. edge of the field;
- the E. pole of PP&L power pole set 1-67 bears N66°25'W 165.79 feet;

The monument was set and references tied using a Trimble R7/R8 RTK GPS system.

Location and comments
 NAD 83/1991 State Plane Coordinate
 Oregon North Zone
 N = 833815.97 ift
 E = 8761909.33 ift

Compass Declination

Surveyors Seal

RECEIVED BY:

Umatilla County Surveyor
 Date: 6/5/2012
 Rec'd By: S. Res
 No. 12-088-c

Firm / Agency
 Witness Tree Surveying
 Address
 P.O. Box G
 Pilot Rock, Or. 97868
 Party Chief
 Stephen K, Haddock

**REGISTERED
 PROFESSIONAL
 LAND SURVEYOR**

Stephen K. Haddock
**OREGON
 JULY 9, 2001
 STEPHEN K. HADDOCK
 56295LS**

RENEWAL DATE 6-30-13