

**OREGON CORNER RESTORATION FORM**

Section 11 Township 5N Range 36E  
 County Umatilla Date: May 8, 2012

Corner Designation: 5N36E17

Corner common to sections 2, 3, 10, and 11,  
 T5N, R36E, W.M., Umatilla County, Oregon.

Previous Renewals / Surveys, etc.


Corner was originally set by Odell and Lewis under contract No. 110 dated February 7, 1865. Their record reads: Set post corner for secs. 2, 3, 10 and 11. Drove charred stake, dug pits, raised mound, as per instructions. In the record of Private Surveys Book 1, Page 397, a map by Peter Zahner calls for "a small pile of stones".

Monument and Accessories found: ( condition and source )

A bent 2" iron pipe at the intersection of plow berms N, S, and E and a few scattered stones.


Condition Report Only  
 Not found  
 Remonumented  
 Unrecorded  
 Surveyed in  
 Referenced out

**DIAGRAM**

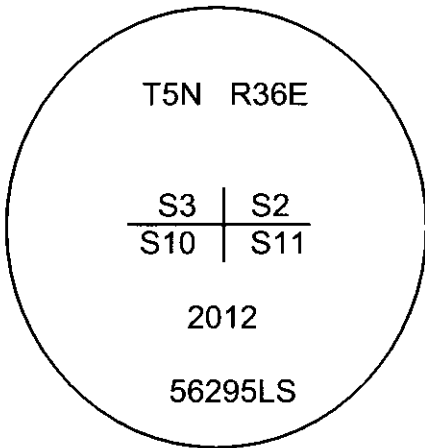

- ⊙ = Brass cap
- = Rebar reference

**SKETCH**

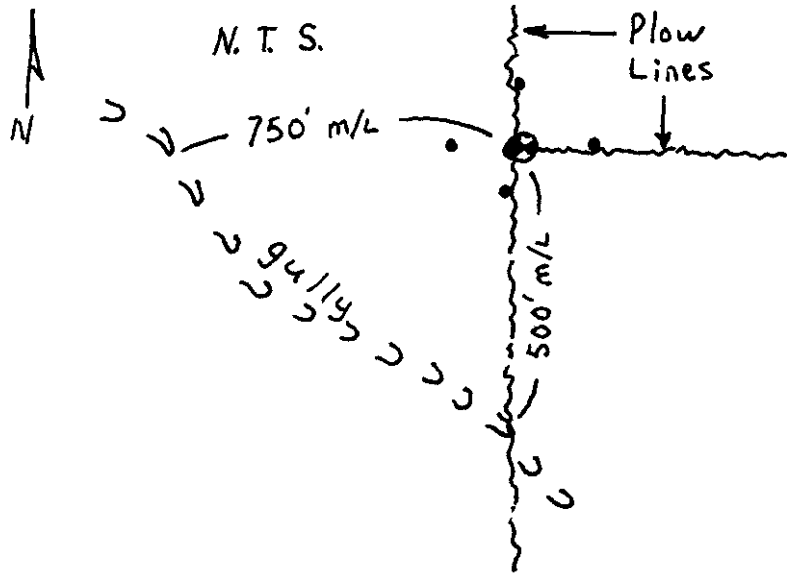

**MONUMENT (S) AND ACCESSORIES SET (Procedures and Description)**

I set a 2 3/8" brass cap on a 1 1/2"x30" galvanized iron pipe with a brass cap stamped as shown in the diagram above 2 feet below the surface. I buried the old pipe along the north side of the cap.

For references: I set 4, 5/8"x24" iron rebars with orange plastic caps stamped WTS and 56295LS as described below 18 inches below the surface of the ground:

- An iron rebar bears N7°28'32"W, 22.83 feet;
- An iron rebar bears N83°56'32"W, 18.37 feet;
- An iron rebar bears S8°26'53"W, 24.56 feet;
- An iron rebar bears N88°27'56"E, 26.48 feet;


The monument and references were tied using a Trimble R7/R8 RTK GPS system.

Location and comments  
 NAD 83/1991 State Plane Coordinate  
 Oregon North Zone  
 N = 833844.08 ift  
 E = 8764679.00 ift


Compass Declination  
  
 Firm / Agency  
 Witness Tree Surveying  
 Address  
 P.O. Box G  
 Pilot Rock, Or. 97868  
 Party Chief  
 Stephen K, Haddock

Surveyors Seal

RECEIVED BY:  
 Umatilla County Surveyor  
 Date: 6/5/2012  
 Rec'd By: A. Res  
 No. 12-088-C

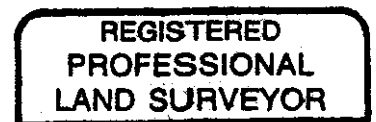

*Stephen K. Haddock*

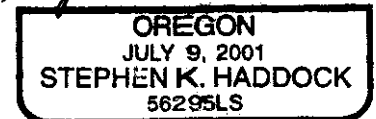

RENEWAL DATE 6-30-13