

**OREGON CORNER RESTORATION FORM**

Section 1 Township 5N Range 36E  
 County Umatilla Date: May 12, 2012

Corner Designation: 5N36E23

Quarter corner common to sections 1 and 12,  
 T5N, R36E, W.M., Umatilla County, Oregon.


Previous Renewals / Surveys, etc.

Corner originally set by Odell and Lewis under contract No. 110 dated February 7, 1865. Their record reads: Set 1/4 Sec. post, drove charred stake, dug pits and raised mound as per instructions.

Monument and Accessories found: ( condition and source )  
 None. The point falls in a plowed field.

Condition Report Only  
 Not found  
 x Remonumented  
 Unrecorded  
 x Surveyed in  
 x Referenced out


**DIAGRAM**

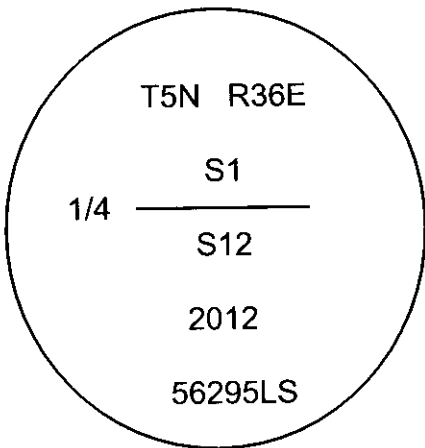

- ⊗ = Brass cap.
- = Rebar reference.
- = Steel guard post.

**SKETCH**

*N. T. S.*

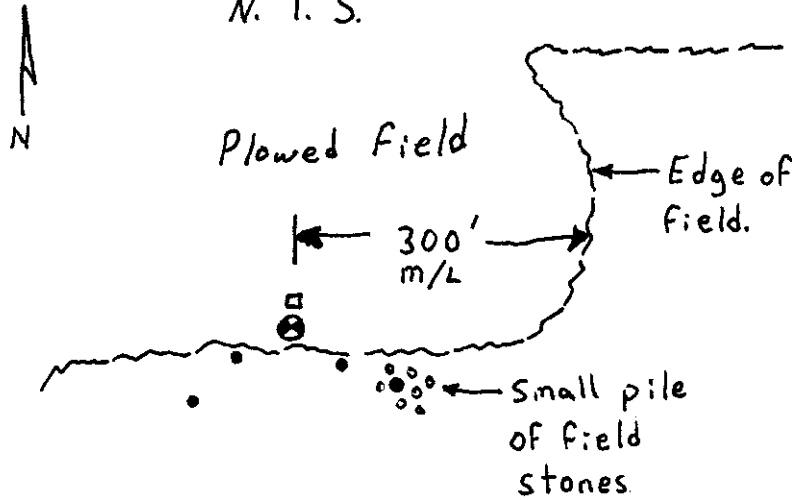

**MONUMENT (S) AND ACCESSORIES SET (Procedures and Description)**

At the proportionate point I set a 1 1/2" x 30" galvanized iron pipe with a 2 3/8" brass cap stamped as shown in the diagram above 28" in the ground to bedrock.

For references I set four 5/8" x 24" iron rebars with orange plastic caps attached marked WTS and 56295LS flush with the surface as described below:

- an iron rebar bears S29°05'25"W, 47.00 feet;
- an iron rebar bears S36°24'46"W, 21.85 feet;
- an iron rebar bears S49°57'05"E, 33.38 feet;
- an iron rebar bears S59°01'17"E, 62.00 feet in a mound of stones;

The monument was set and references tied using a Trimble R7/R8 RTK GPS system.

Location and comments  
 NAD 83/1991 State Plane Coordinate  
 Oregon North Zone  
 N = 834363.16 ift  
 E = 8772597.78 ift

Compass Declination

Surveyors Seal

Firm / Agency  
 Witness Tree Surveying  
 Address  
 P.O. Box G  
 Pilot Rock, Or. 97868  
 Party Chief  
 Stephen K, Haddock

**REGISTERED  
 PROFESSIONAL  
 LAND SURVEYOR**

*Stephen K. Haddock*

**OREGON  
 JULY 9, 2001  
 STEPHEN K. HADDOCK  
 56295LS**

**RENEWAL DATE 6-30-13**

**RECEIVED BY:**

Umatilla County Surveyor  
 Date: 6/5/2012  
 Rec'd By: S. [Signature]  
 No. 12-088-C