

OREGON CORNER RESTORATION FORM

Section 5 Township 5N Range 36E
 County Umatilla Date: July 5, 2012

Corner Designation: 5N36E5

Condition Report Only
 Not found
 Remonumented
 Unrecorded
 Surveyed in
 Referenced out

Corner common to sections 5, 6, 7, and 8,
 T5N, R36E, W.M., Umatilla County, Oregon.


Previous Renewals / Surveys, etc.

Corner was originally set by Odell and Lewis under contract No. 110 dated February 7, 1865. Their record reads: Set post corner for secs. 5, 6, 7 and 8. Drove charred stake, dug pits, raised mound, as per instructions. In the record of Private Surveys Book 1, Page 393 (survey No. 100) John Kimbrell reports finding a stone, firmly set to perpetuate the original corner and is undisputed.

Monument and Accessories found: (condition and source)


The intersection of a road centerline west and a field line south. This agrees with Kimbrell's distance to the "gulch" to the east.

DIAGRAM

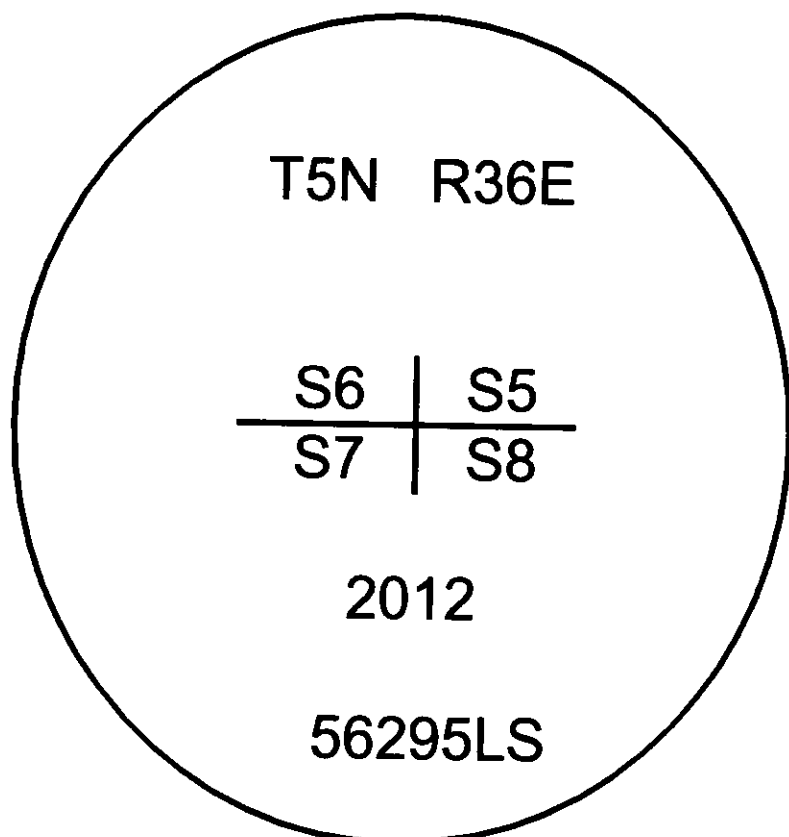

- = Wood Fence post
- = Rebar Reference
- ⊙ = Brass Cap

SKETCH

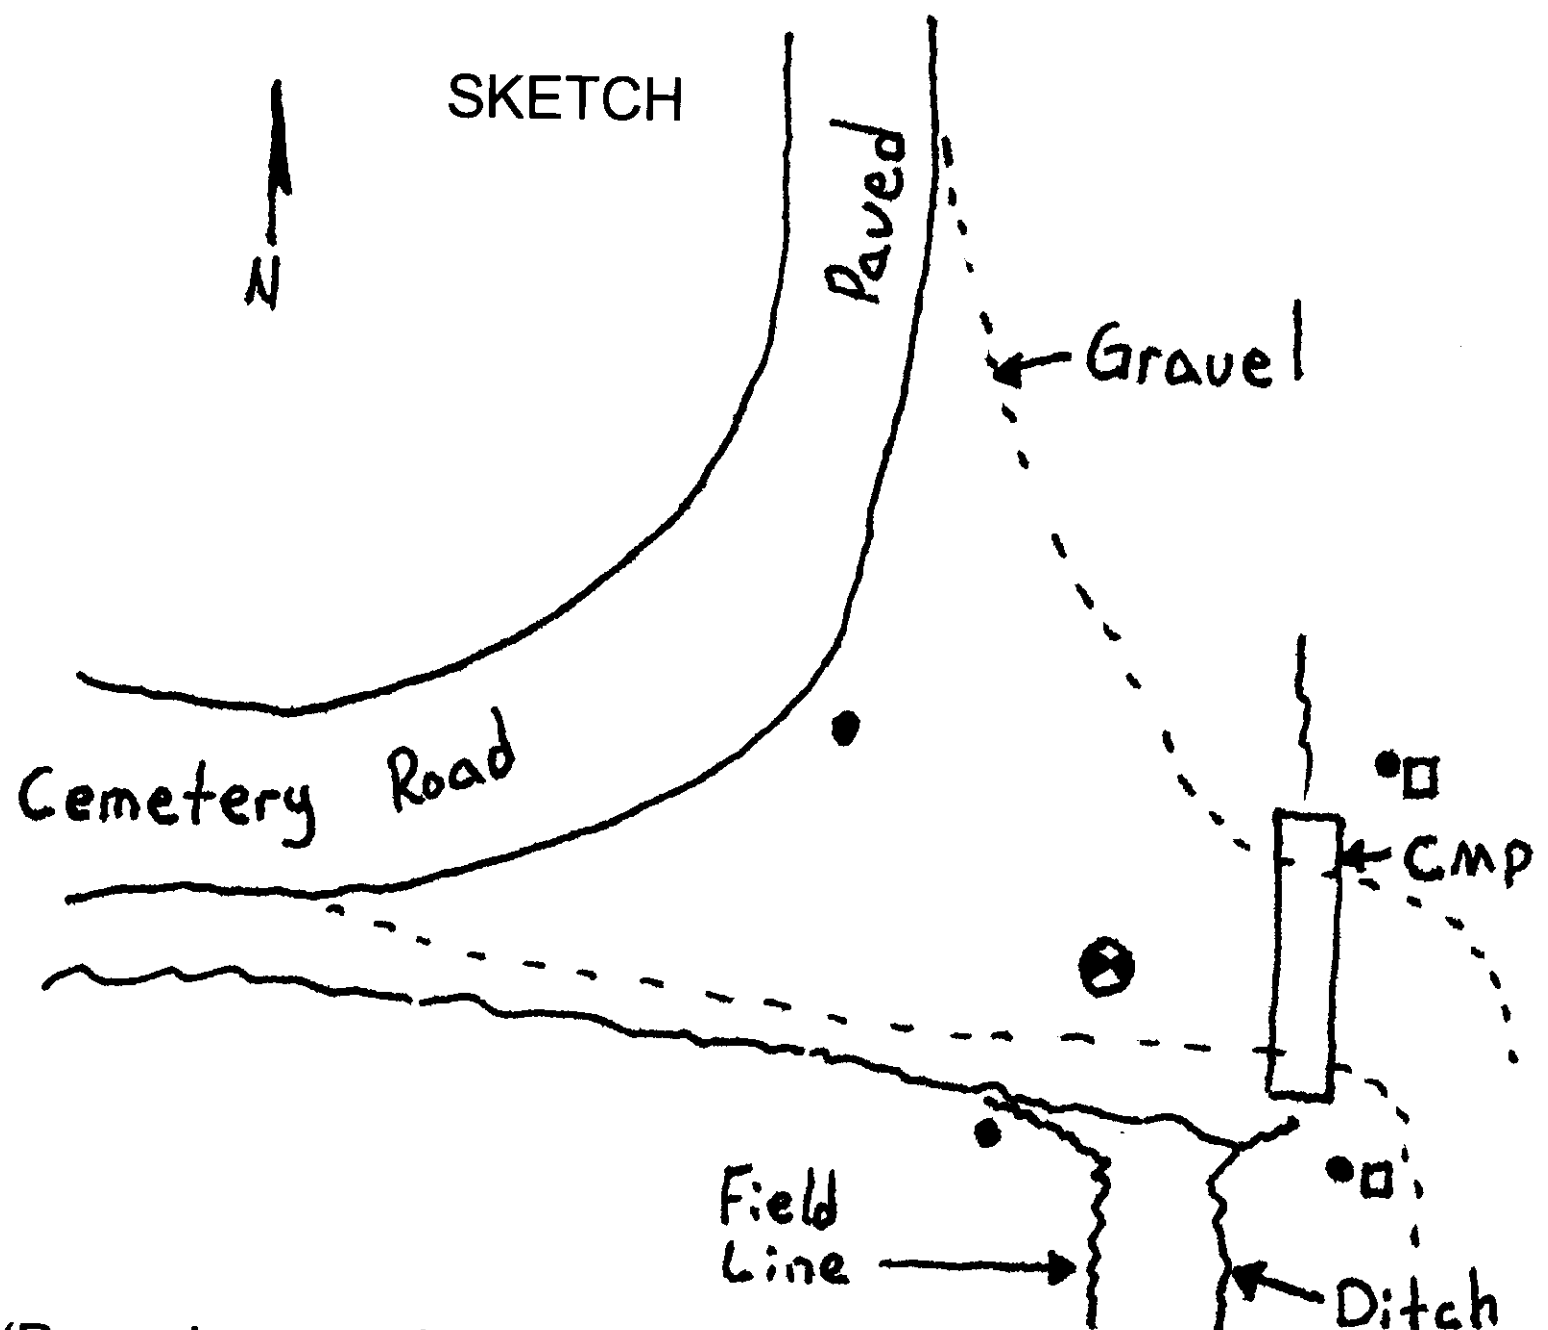

MONUMENT (S) AND ACCESSORIES SET (Procedures and Description)

I set a 2 3/8" brass cap on a 1 1/2"x30" galvanized iron pipe with a brass cap stamped as shown in the diagram above at the intersection described above.

For references: I set 4, 5/8"x24" iron rebars with orange plastic caps stamped WTS and 56295LS as described below:

- An iron rebar bears N41°00'04"W, 24.27 feet;
- An iron rebar bears S35°40'17"W, 28.37 feet;
- An iron rebar bears S60°46'20"E, 27.42 feet;
- An iron rebar bears N49°23'01"E, 31.78 feet;

The monument and references were tied using a Trimble R7/R8 RTK GPS system.

Location and comments
 NAD 83/1991 State Plane Coordinate
 Oregon North Zone
 N = 833299.09 ift
 E = 8748659.23 ift

Compass Declination

Surveyors Seal

Firm / Agency
 Witness Tree Surveying
 Address
 P.O. Box G
 Pilot Rock, Or. 97868
 Party Chief
 Stephen K, Haddock

REGISTERED
 PROFESSIONAL
 LAND SURVEYOR

Stephen K. Haddock

OREGON
 JULY 9, 2001
 STEPHEN K. HADDOCK
 56295LS

RENEWAL DATE 6-30-13

RECEIVED BY:

Umatilla County Surveyor
 Date: 12/6/2012
 Rec'd By: A. [Signature]
 No. 12-155-B