

**OREGON CORNER RESTORATION FORM**

Section 8 Township 5N Range 36E  
 County Umatilla Date: July 20, 2012

Corner Designation: 5N36G9

Condition Report Only  
 Not found  
 Remonumented  
 Unrecorded  
 Surveyed in  
 Referenced out


Quarter corner common to sections 8 and 9, T5N, R36E, W.M., Umatilla County, Oregon.

Previous Renewals / Surveys, etc.

Corner was originally set by Odell and Lewis under contract No. 110 dated February 7, 1865. Their record reads: Set 1/4 Sec. post. Drove charred stake, dug pits and raised mound as per instructions. In the record of private surveys Book , Page 393, John Kimbrell reports: Found mound and pits almost obliterated. The old cottonwood post fairly well preserved in a small mound of stone.


Monument and Accessories found: ( condition and source )  
 None. This point falls in a plowed field.

**DIAGRAM**

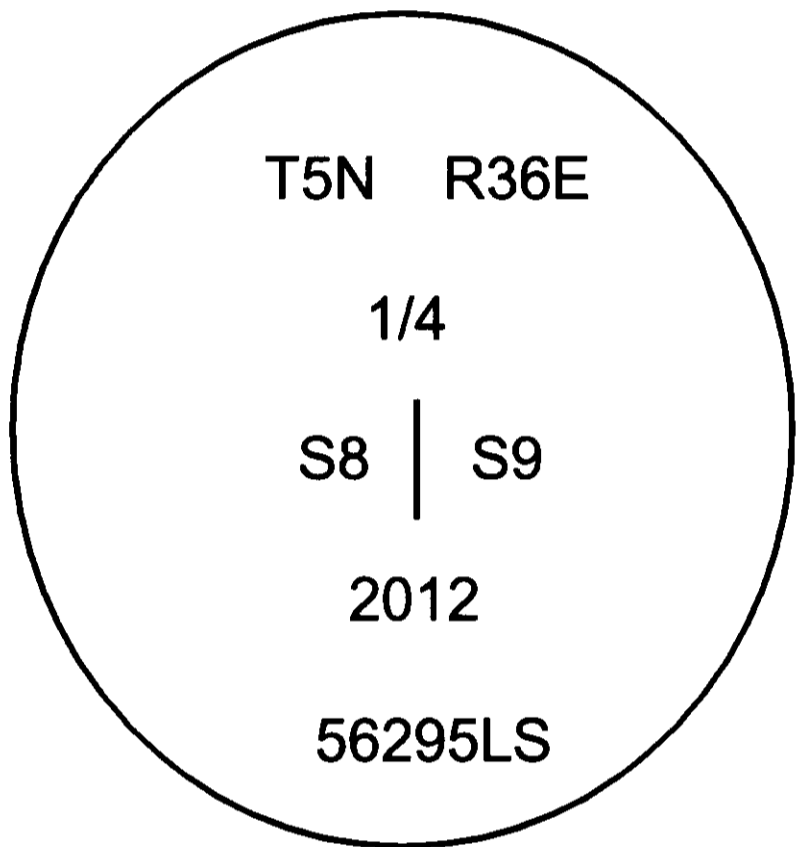

- ⊙ = Brass Cap
- = Rebar Reference

**SKETCH**

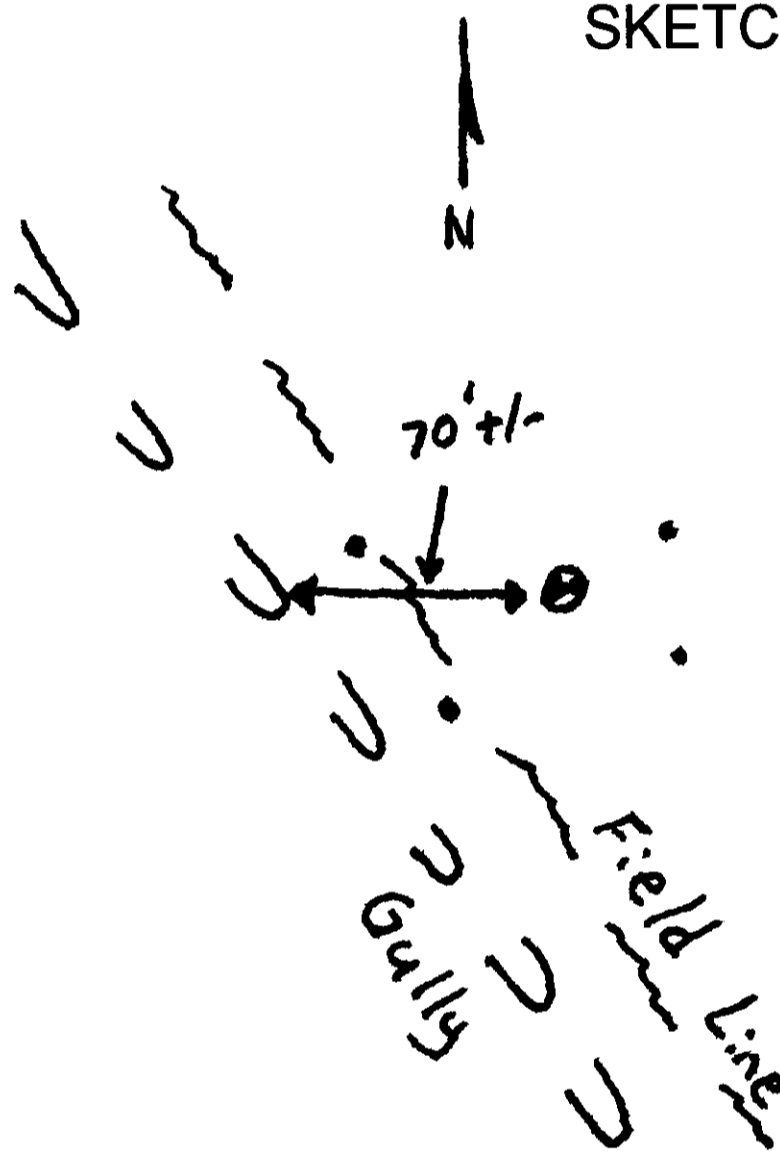

**MONUMENT (S) AND ACCESSORIES SET (Procedures and Description)**

I set a 1 1/2" x 30" galvanized iron pipe with a 2 3/8" brass cap stamped as shown in the diagram above 2 feet below the surface of the plowed field at the position determined from Kimbrell's record.

For references, I set four 5/8" by 24" iron rebars with 1 1/8" orange plastic caps stamped WTS and 56295LS as described below:

- an iron rebar bears N65°41'34"W, 48.93 feet, west of the west edge of the field;
- an iron rebar bears N27°30'04"E, 27.38 feet, 20 inches below the surface;
- an iron rebar bears S69°04'55"E, 26.86 feet, 20 inches below the surface;
- an iron rebar bears S26°24'36"W, 49.01 feet, west of the west edge of the field;

The monument was set and references tied using a Trimble R7/R8 RTK GPS.

Location and comments  
 NAD 83/1991 State Plane Coordinate  
 Oregon North Zone  
 N = 830963.57 ift  
 E = 8754514.69 ift

Compass Declination

Surveyors Seal

RECEIVED BY:  
 Umatilla County Surveyor  
 Date: 12/6/2012  
 Rec'd By: [Signature]  
 No. 12-155-1B

Firm / Agency  
 Witness Tree Surveying  
 Address  
 P.O. Box G  
 Pilot Rock, Or. 97868  
 Party Chief  
 Stephen K, Haddock

REGISTERED  
 PROFESSIONAL  
 LAND SURVEYOR

[Signature]

OREGON  
 JULY 9, 2001  
 STEPHEN K. HADDOCK  
 56295LS

RENEWAL DATE 6-30-13