

**OREGON CORNER RESTORATION FORM**

Section 15 Township 5N Range 36E  
 County Umatilla Date: May 8, 2012

Corner Designation: 5N36J15

Quarter corner common to sections 10 and 15,  
 T5N, R36E, W.M., Umatilla County, Oregon.


Condition Report Only  
 Not found  
 Remonumented  
 Unrecorded  
 Surveyed in  
 Referenced out

Previous Renewals / Surveys, etc.

Corner originally set by Odell and Lewis under contract No. 110 dated February 7, 1865. Their record reads: Set 1/4 Sec. post, drove charred stake, dug pits and raised mound as per instructions.


Monument and Accessories found: ( condition and source )  
 The point falls in an E-W plow berm.

**DIAGRAM**

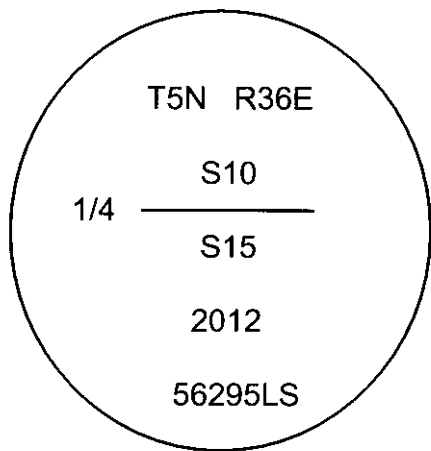

- ⊙ = Brass cap.
- = Steel guard post.
- = Rebar reference.

**SKETCH**  
 N. T. S.

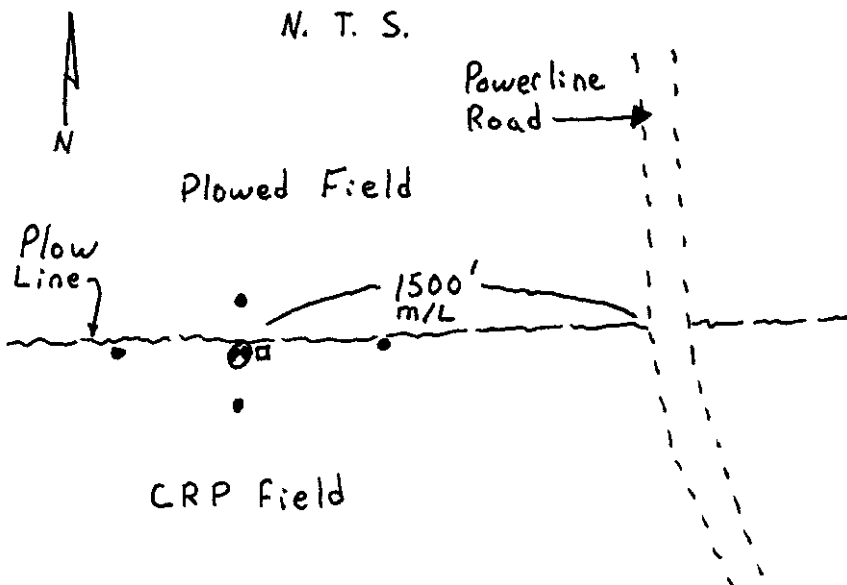

**MONUMENT (S) AND ACCESSORIES SET (Procedures and Description)**

At the proportionate point, which falls in the plow berm, I set a 1 1/2" galvanized iron pipe with a 2 3/8" brass cap stamped as shown in the diagram above.

For references, I set four 5/8" by 24" iron rebars with 1 1/4" orange plastic caps stamped WTS and 56295LS as described below:

- an iron rebar bears N1°52'24"W, 25.09 feet, 2 feet below the surface;
- an iron rebar bears S87°22'27"W, 26.29 feet;
- an iron rebar bears N86°48'57"E, 27.98 feet;
- an iron rebar bears S7°04'16"E, 26.89 feet 2 feet below the surface;

The monument was set and references tied using a Trimble R7/R8 RTK GPS system.

Location and comments  
 NAD 83/1991 State Plane Coordinate  
 Oregon North Zone  
 N = 828591.78 ift  
 E = 8762003.16 ift

Compass Declination  
 Firm / Agency  
 Witness Tree Surveying  
 Address  
 P.O. Box G  
 Pilot Rock, Or. 97868  
 Party Chief  
 Stephen K, Haddock

Surveyors Seal

**REGISTERED  
 PROFESSIONAL  
 LAND SURVEYOR**

*Stephen K. Haddock*

OREGON  
 JULY 9, 2001  
 STEPHEN K. HADDOCK  
 56295LS

RENEWAL DATE 6-30-13

RECEIVED BY:  
 Umatilla County Surveyor  
 Date: 6/5/2012  
 Rec'd By: A. Green  
 No. 12-088-C