

OREGON CORNER RESTORATION FORM

Section 17 Township 5N Range 36E
 County Umatilla Date: September 25, 2012

Corner Designation: 5N36L9


Condition Report Only
 Not found
 Remonumented
 Unrecorded
 Surveyed in
 Referenced out

Quarter corner common to sections 16 and 17, T5N, R36E, W.M., Umatilla County, Oregon.

Previous Renewals / Surveys, etc.

Corner was originally set by Odell and Lewis under contract No. 110 dated February 7, 1865. Their record reads: Set 1/4 Sec. post. Drove charred stake, dug pits and raised mound as per instructions.

Monument and Accessories found: (condition and source)
 None. This point falls in a plowed field.

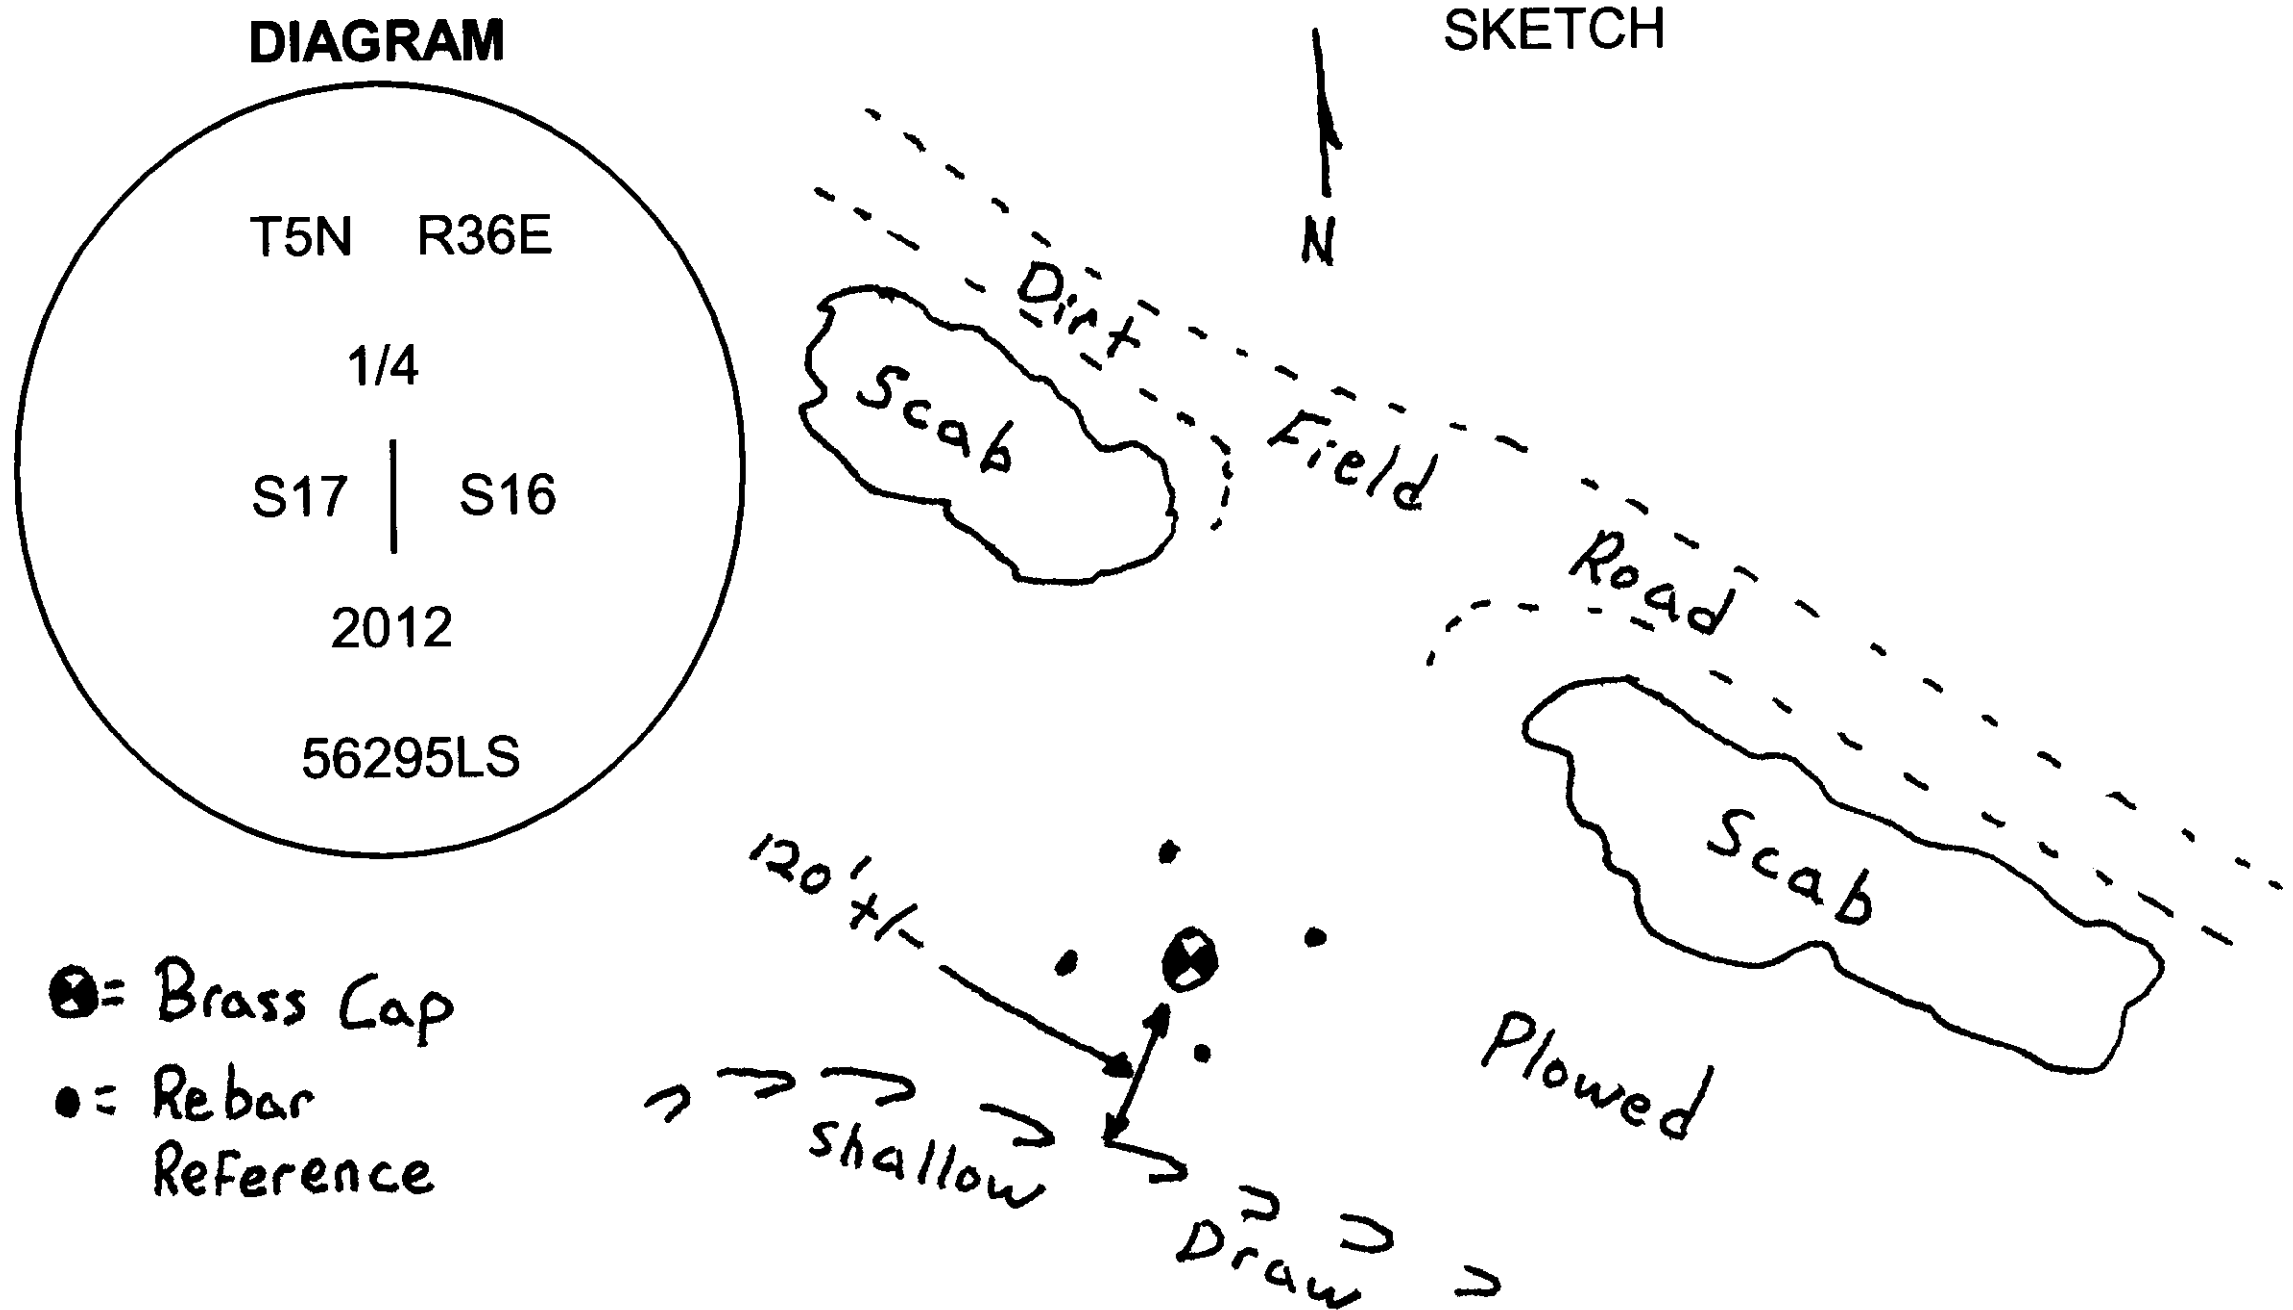

- ⊗ = Brass Cap
- = Rebar Reference

MONUMENT (S) AND ACCESSORIES SET (Procedures and Description)

Set a 1 1/2" x 30" galvanized iron pipe with a 2 3/8" brass cap stamped as shown in the diagram above 20" below the surface of the field at the proportionate point.

For references, I set four 5/8" by 24" iron rebars with 1 1/8" orange plastic caps stamped WTS and 56295LS as described below 20" below the surface:

- an iron rebar bears S88°06'47"W, 27.01 feet;
- an iron rebar bears N6°20'35"W, 32.26 feet;
- an iron rebar bears N77°41'18"E, 27.74 feet;
- an iron rebar bears S7°41'55"E, 26.86 feet;

The monument was set and references tied using a Trimble R7/R8 RTK GPS.

Location and comments
 NAD 83/1991 State Plane Coordinate
 Oregon North Zone
 N = 825541.78 ift
 E = 8754445.59 ift

Compass Declination
 Firm / Agency
 Witness Tree Surveying
 Address
 P.O. Box G
 Pilot Rock, Or. 97868
 Party Chief
 Stephen K, Haddock

Surveyors Seal

REGISTERED
 PROFESSIONAL
 LAND SURVEYOR

Stephen K. Haddock

OREGON
 JULY 9, 2001
 STEPHEN K. HADDOCK
 56295LS

RENEWAL DATE 6-30-13

RECEIVED BY:
 Umatilla County Surveyor
 Date: 12/6/2012
 Rec'd By: [Signature]
 No. 12-155-B