

Index
File No. #-1

CORNER RECORD (SEARCH)


(Ref. FSM 7151.4)

Tract or Survey No. _____ Cor. No. 7

T 5 N. R. 39 E. R.D. Walla Walla County Umatilla

Merid. W.M. N.F. Umatilla State Oregon

CORNER DIAGRAM

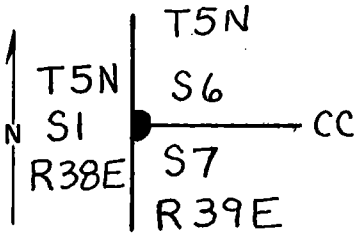

1935

DESCRIBE CORNER MONUMENT FOUND

Iron post with brass cap approx. 6 inches above ground.
Condition good, post solid.

DESCRIBE BEARING TREES OR OTHER OFFICIAL ACCESSORIES FOUND

40" dbh fir in Sec. 7, 59 links scribing visible
40" dbh fir in Sec. 6, 81 links scribing barely visible

PHOTO IDENTIFICATION DATA

Photo No. _____

Filed At. _____

Object Ident. _____

Ident. By _____

Signature

PLANE COORDINATE POSITION DATA

State _____ Zone _____

X _____

Y _____

Estab. By _____

Agency

DESCRIBE CORNER LOCATION RELATIVE TO NEAR-BY FEATURES, ALSO HOW TO REACH CORNER

Signature

James C. Wood

Title

Dist. Eng.

Division

Eng.

Headquarters

Walla Walla

Date

9/73

7100-52 (3/68)

CORNER RECORD (PERPETUATION)

MONUMENT : DESCRIBE NEW MONUMENT SET, OR WORK DONE TO PRESERVE EXISTING MONUMENT

9

ACCESSORIES : DESCRIBE NEW BT's WITNESS OBJECTS ETC. ESTABLISHED, OR WORK DONE TO PRESERVE EXISTING EVIDENCE

10

Work Done By _____ Title _____ Date _____ State Registration No. or Agency _____

Certified Cor. Record Prepared ? Yes No Filed At: _____ Date _____

11

REMARKS

12

Index File No. *E-1* T. R. M. Tract or Surv. No. Cor. _____

13